


7# 4-2-2

# T.2N. R.14E. W.M.

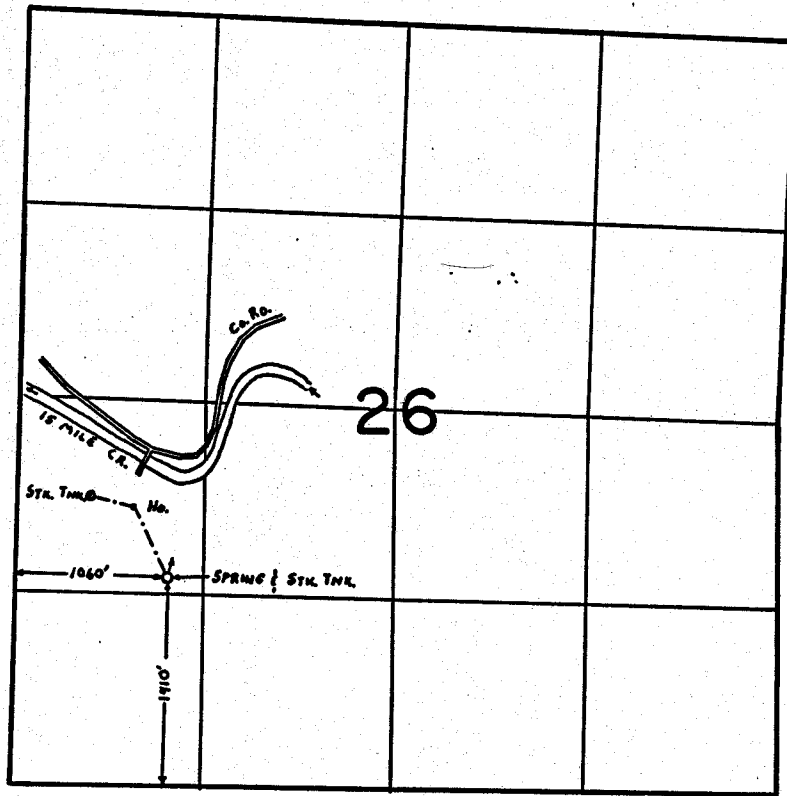

## FINAL PROOF SURVEY UNDER

Application No. 57468... Permit No. 43252...  
IN NAME OF

.....MAUDE CALDWELL.....

Surveyed June 25 1979, by C. L. HUGHES...