



T.1S., R.13&14E., W.M.

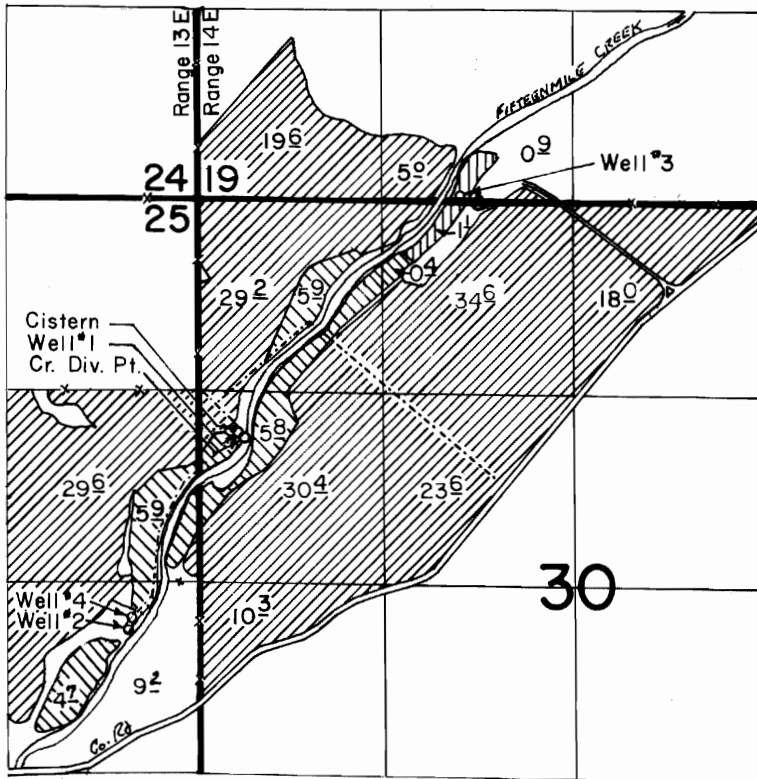

Well #1 (App. G-8440) Loc. 1030' N. & 280' E.
 Well #2 (App. G-9193) Loc. 330' S. & 500' W.
 Well #3 (App. G-9476) Loc. 2650' N. & 1810' E.
 Well #4 (App. G-10018) Loc. 230' S. & 470' W.
 Creek Div. (App. 59516) Loc. 980' N. & 310' E.
 All Measurements are from the W1/4 Cor. Sec. 30

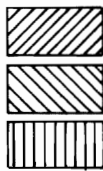

Primary Well #1 (App. G-8440)
 Supplemental Well #2 (App G-9193), Well #4 (App. G-10018) & Creek (App. 59516)
 Supplemental Well #1 (App. G-8440), Well #2 (App. G-9193), & Well #4 (App. G-10018)
 Supplemental Well #3 (App. G-9476)

FINAL PROOF SURVEY

UNDER
 59516 44816
 G-8440 G-7869
 G-9193 G-8673
 G-9476 G-8835
 Application No. G-10018 Permit No. G-9552
 IN NAME OF

WILBUR J. PETERSEN

Surveyed Oct. 25, 1982, by T. J. Paul