


G-8295

# T.1S., R.14E., W.M.

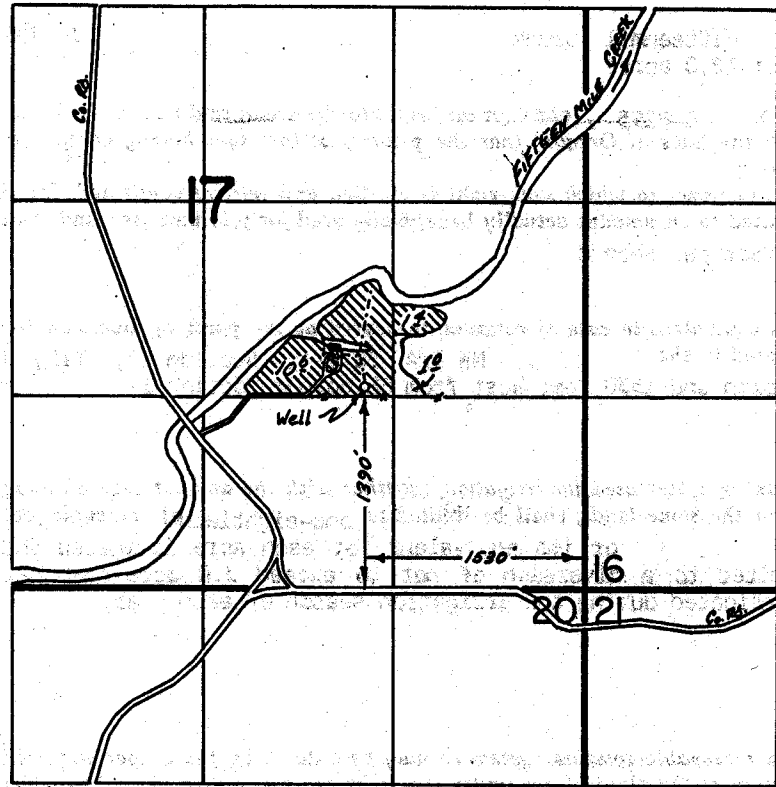

## FINAL PROOF SURVEY UNDER

Application No. G-8911... Permit No. G-8295  
IN NAME OF

.....NEIL E. WUDANEN.....

Surveyed Oct. 11, 1982, by T. J. Paul.....