


T.1N., R.14E., W.M.

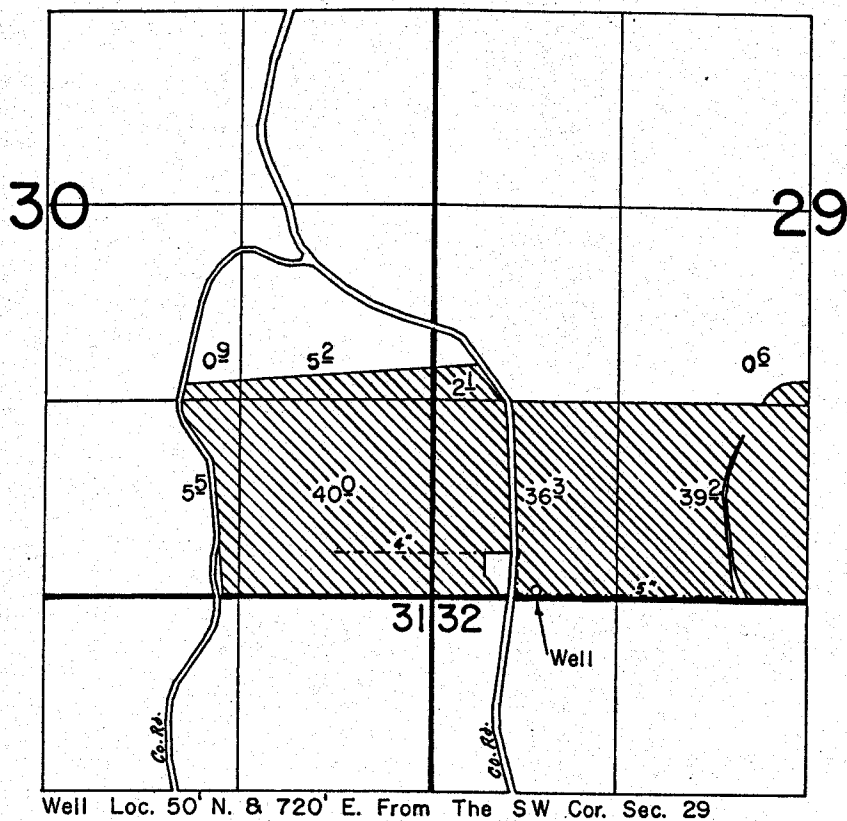

FINAL PROOF SURVEY UNDER

Application No. G-8989. Permit No. G-8364.
IN NAME OF

GEORGE R. & LAVELLE OVERMAN

Surveyed Oct. 11 & 15 1982, by T. J. PAUL