


T.5S., R.1E., W.M.

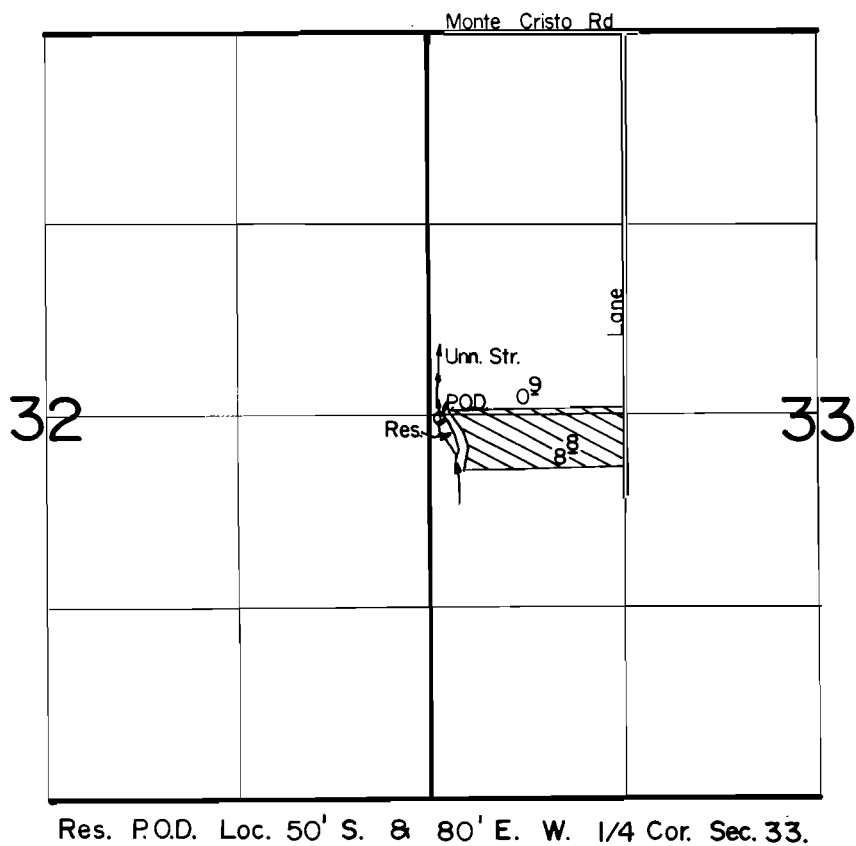

Scale: 1" = 1320'

FINAL PROOF SURVEY UNDER

R-61060 R-8317
Application No. 61705 Permit No. 4611
IN NAME OF

AFANASY REUTOV

Surveyed JULY 12, 1985, by T. Warren