


T.5S., R.1E., W.M.

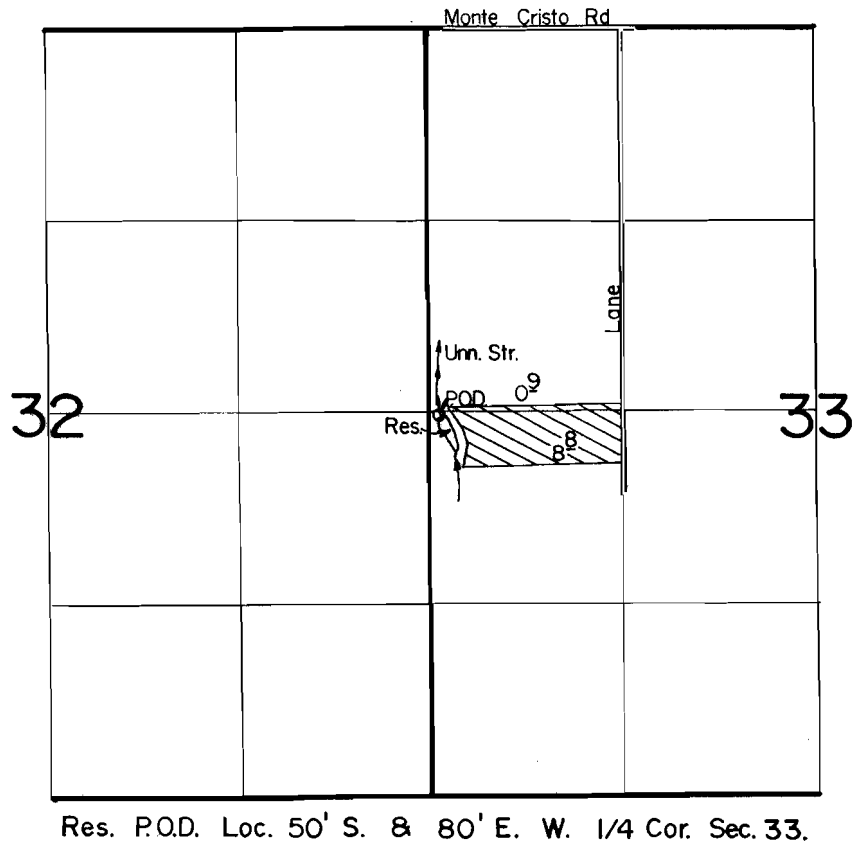

Res. P.O.D. Loc. 50' S. & 80' E. W. 1/4 Cor. Sec. 33.

Scale: 1" = 1320'

FINAL PROOF SURVEY UNDER

R-61060 R-8317
Application No. 61705 Permit No. 46111
IN NAME OF

AFANASY REUTOV

Surveyed JULY 12, 1985, by T. Warren