


T. 27S., R. 12W., W.M.

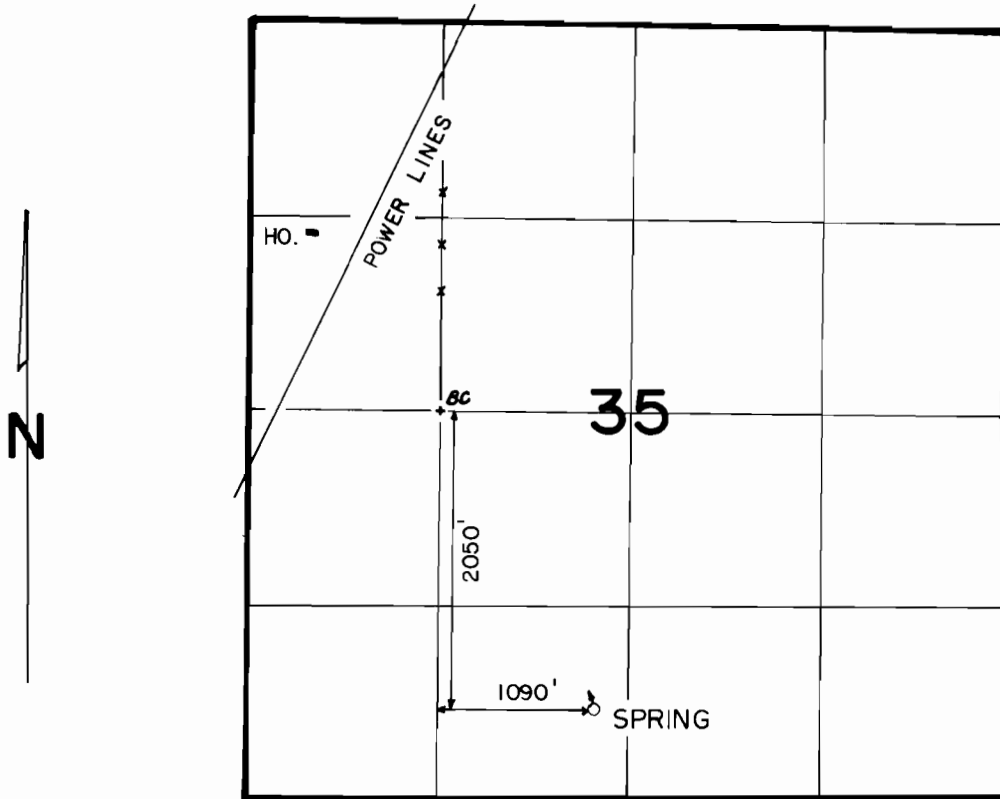

SCALE: 4" = 1 mile

FINAL PROOF SURVEY
UNDER

Application No. 53895... Permit No. 40214.....
IN NAME OF

..... L. G. SANDERS

Surveyed OCT. 11... 1983, by *L.E. Cashion*.....