


NORTHWEST CORNER OF CURRY COUNTY MAP # 41-12, TAX LOT # 2600, (SECTION 9)

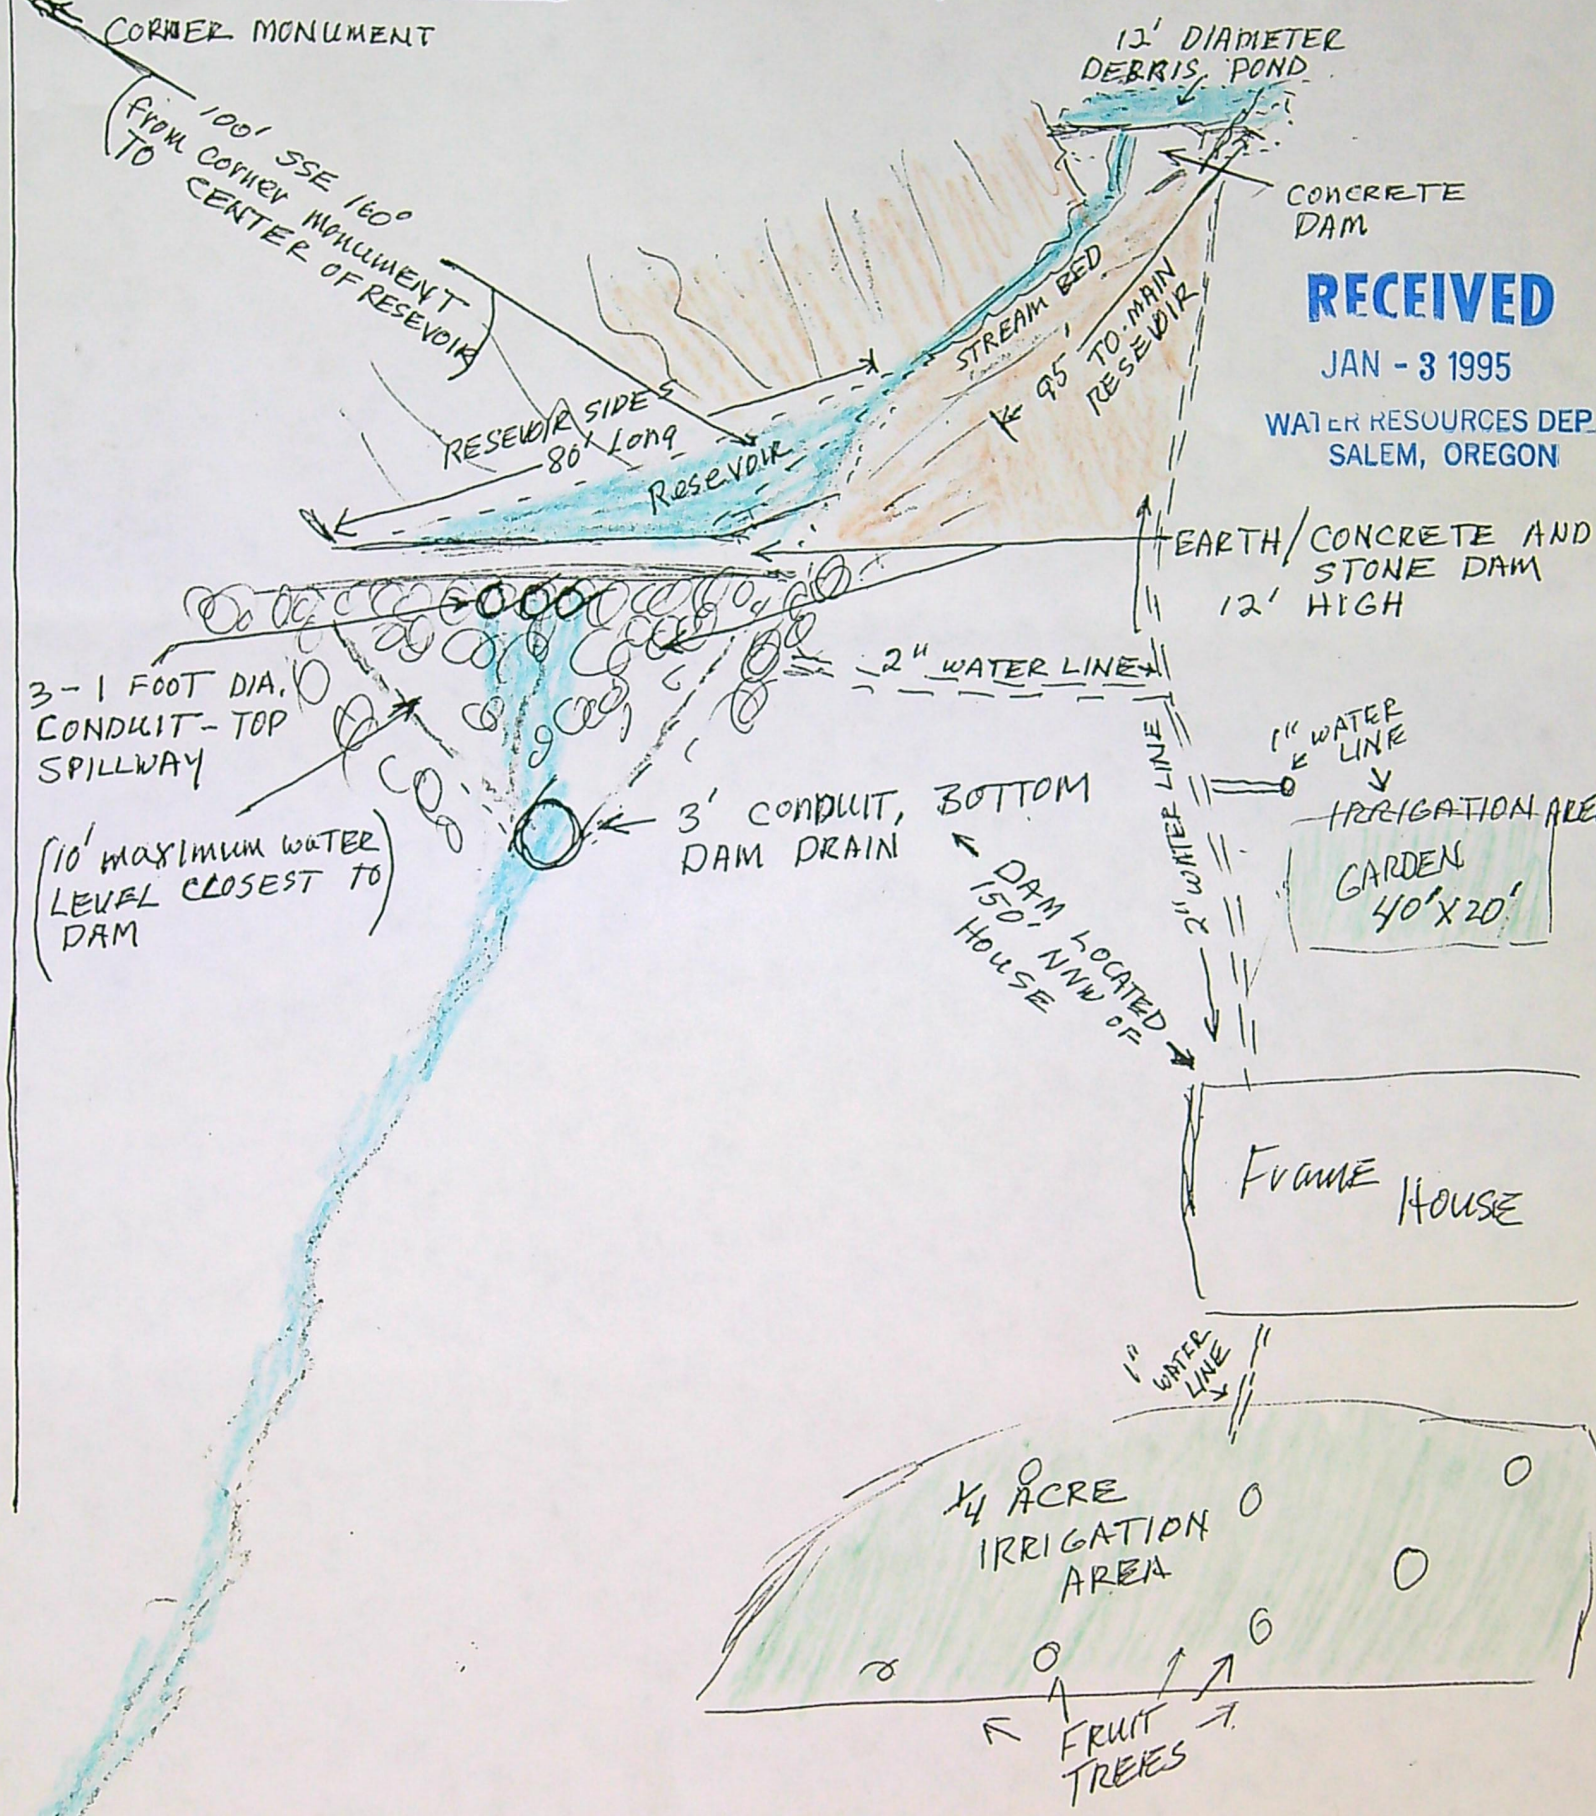

**RECEIVED**

JAN - 3 1995

WATER RESOURCES DEP.  
SALEM, OREGON

Application No. R-76578  
Permit No.

No

Final Proof

Map

Available