


RECEIVED

TZ8S R14W
Sec 5

WATER RESOURCES DEPT

Application No. 61826
Permit No. 46041

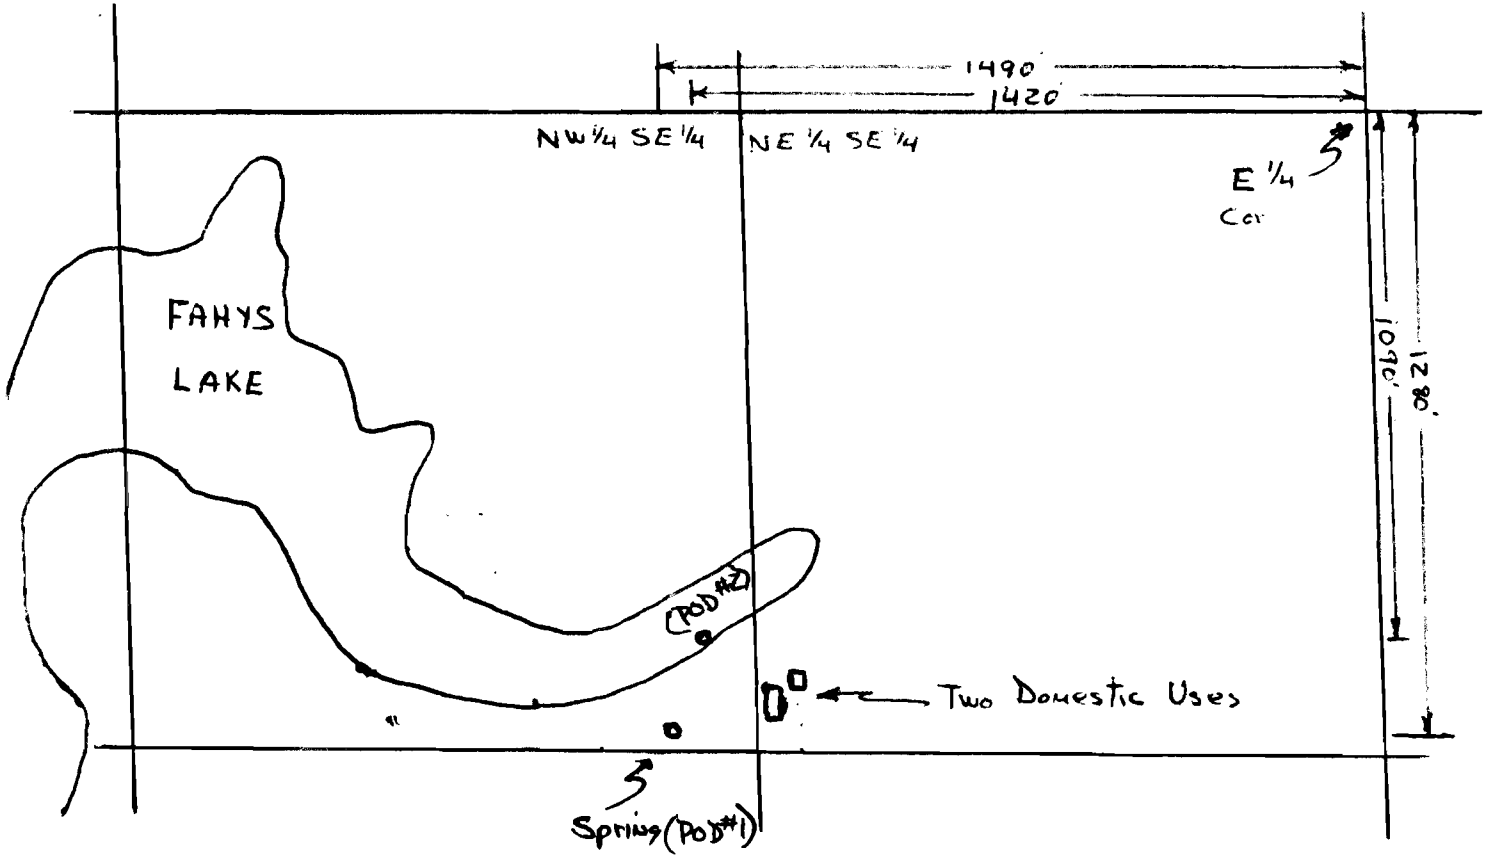

W + E
Scale
1" = 400'