


T.28S. R.14W. W.M.

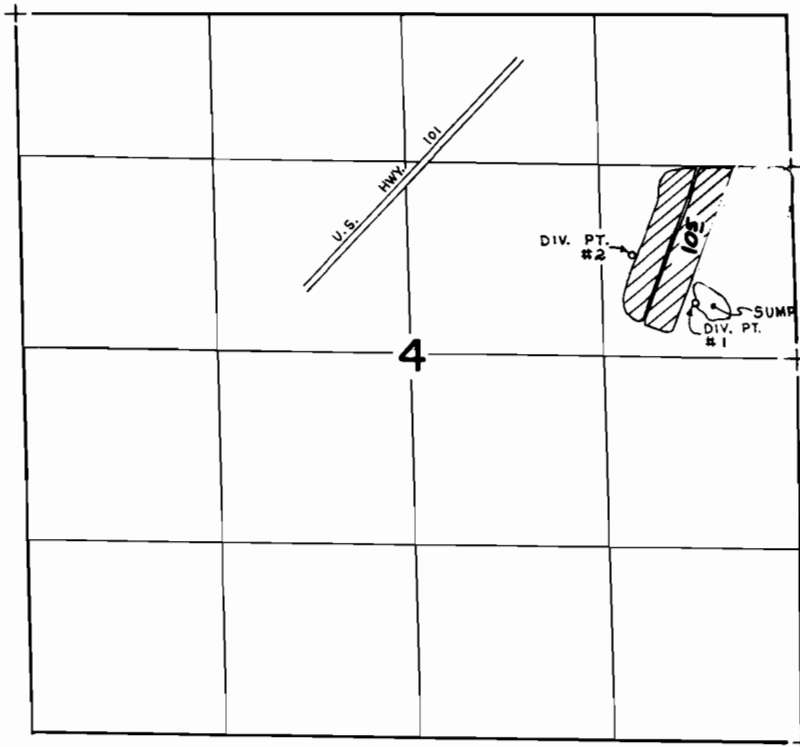

DIV. PT. #1 LOCATED 390' N. & 700' W. FROM E. 1/4 CORNER SECTION 4
DIV. PT. #2 LOCATED 710' N. & 1,135' W. FROM E. 1/4 CORNER SECTION 4

SCALE: 4" = 1 mile

FINAL PROOF SURVEY UNDER

Application No. G-844.1 Permit No. G-7927.
IN NAME OF

REX PIERCE

Surveyed NOV. 1, 1983, by J. CASHION