


T.16S., R.18E., W.M.

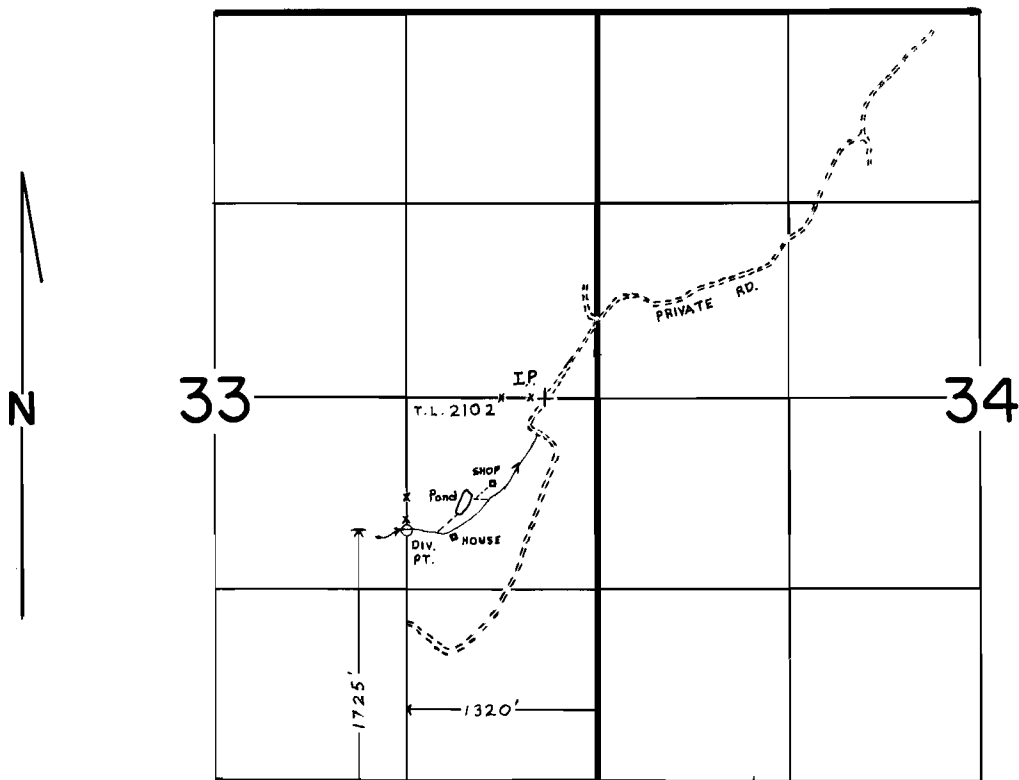

SCALE: 1" = 1320'

# FINAL PROOF SURVEY

UNDER

Application No. 63488 Permit No. 47253  
IN NAME OF

GORDON A. FAHLGREN

Surveyed OCT. 9 1985, by LESLIE OLSON