


T.17S., R.21E., W.M.

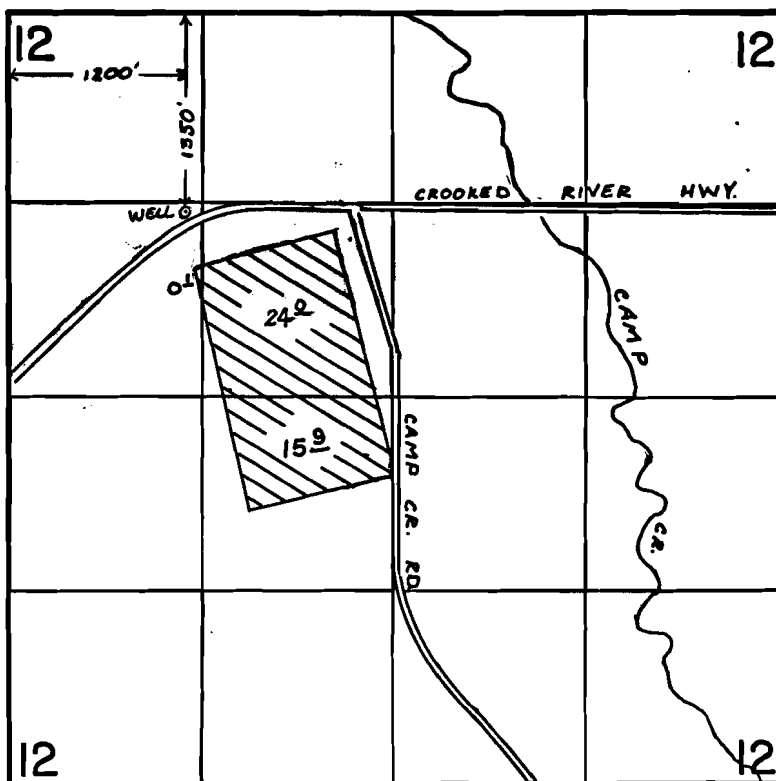

SCALE : 1" = 1320'

**FINAL PROOF SURVEY**  
UNDER

Application No. G-11300.. Permit No. G-10430... C-55660  
IN NAME OF

**L.S. RANCH**

Surveyed OCT. 28. 1985., by L. OLSON.....

*Basin 5, Vol. 2  
Crooked Riv. Misc.*

*Cert. 55660*