


T.14 S., R.13 E., W.M.

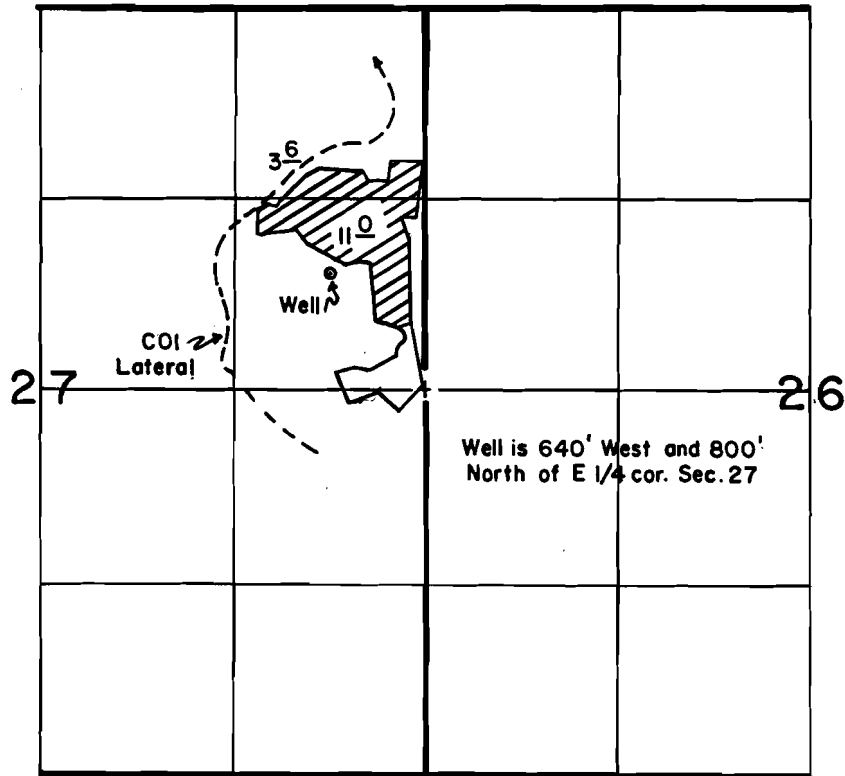

FINAL PROOF SURVEY
UNDER

Application No. G-9147.. Permit No. G-8468..
IN NAME OF

BURT L. JR., & VIRGINIA J. BURTON

Surveyed OCT. 10... 1983, by D. PANTHER.....

Basin 5, Vol. 2
Crooked Riv. Wells

Cert. 55661