


T.26S. R.6W. W.M.

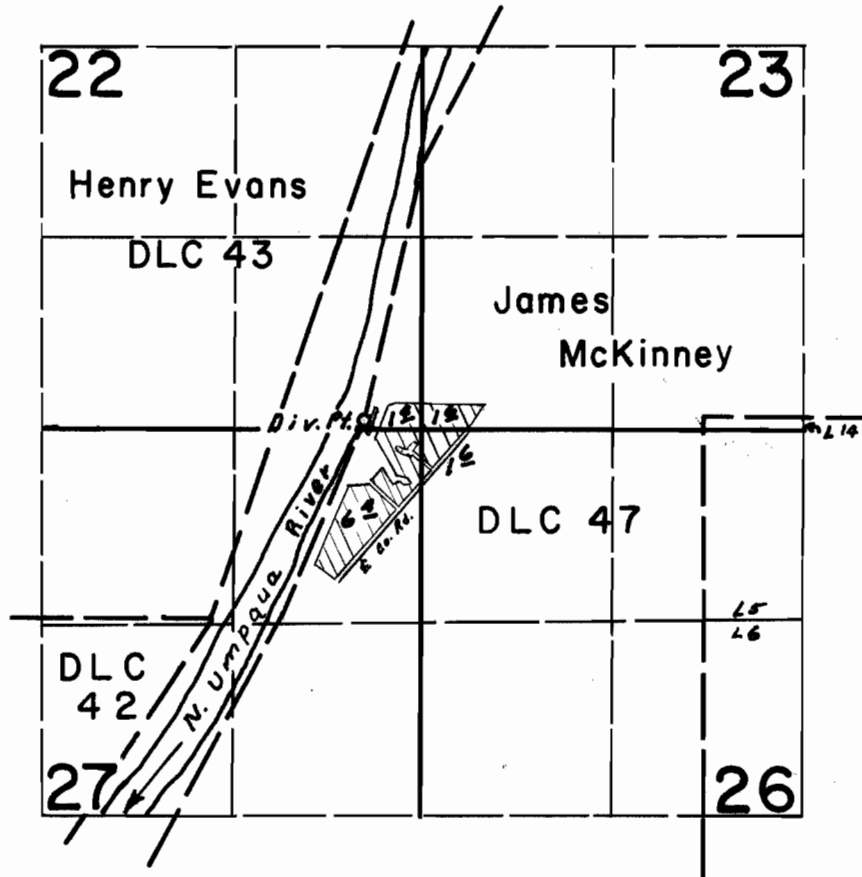

**FINAL PROOF SURVEY**  
UNDER

Application No. 37877. Permit No. 28229.  
IN NAME OF

**CURTIS TRENT**

Surveyed July 14, 1964, by *C. J. Gardner*