


T.32S.,R.5W.,W.M.

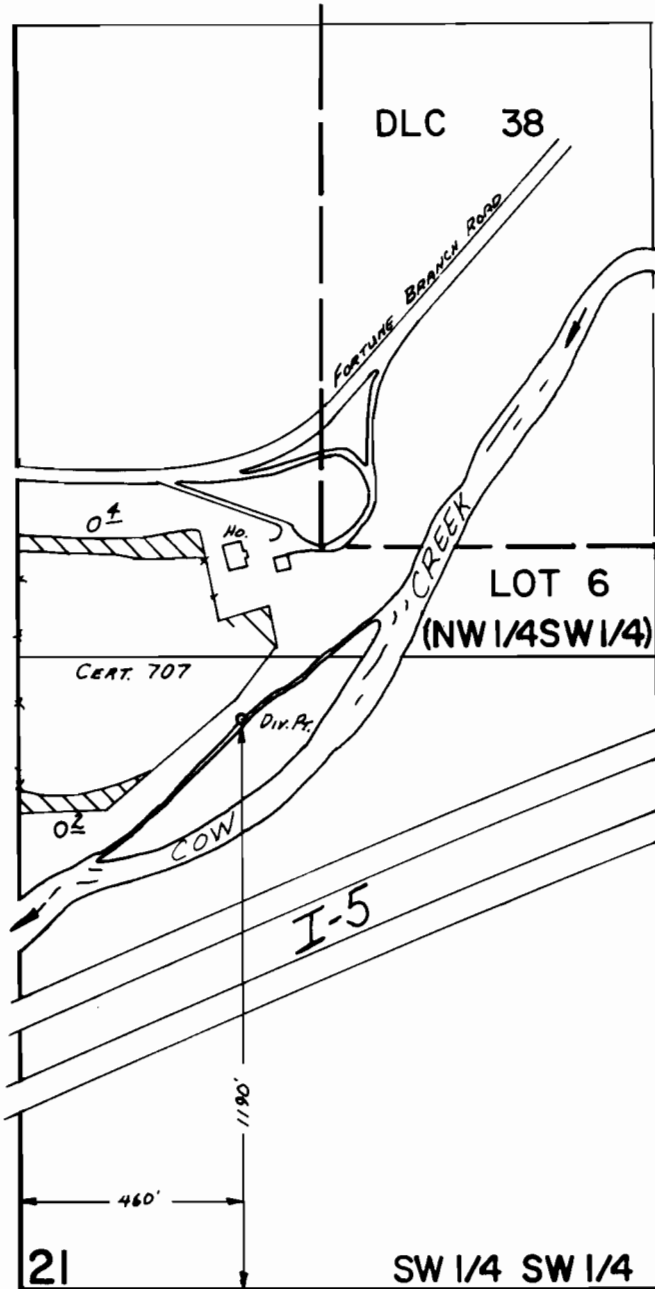

FINAL PROOF SURVEY
UNDER

Application No. 50628.. Permit No. 38256.....
IN NAME OF

CLIFFORD E. LANDERS

Surveyed Oct. 15... 1979., by J. S. DONALDSON