


T.28S., R.4W., W.M.

SEC. 28

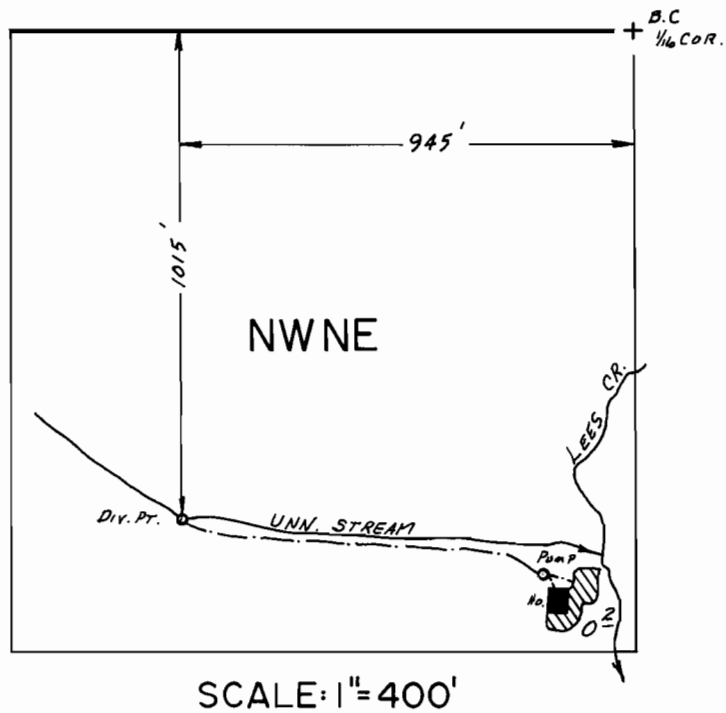

FINAL PROOF SURVEY
UNDER

Application No. 51337... Permit No. 38756...
IN NAME OF

GEORGIA & HENRY HARDERS

Surveyed JUNE 12, 1980, by J.S. DONALDSON