


T.26S. R.5W. W.M.

Sec. 26

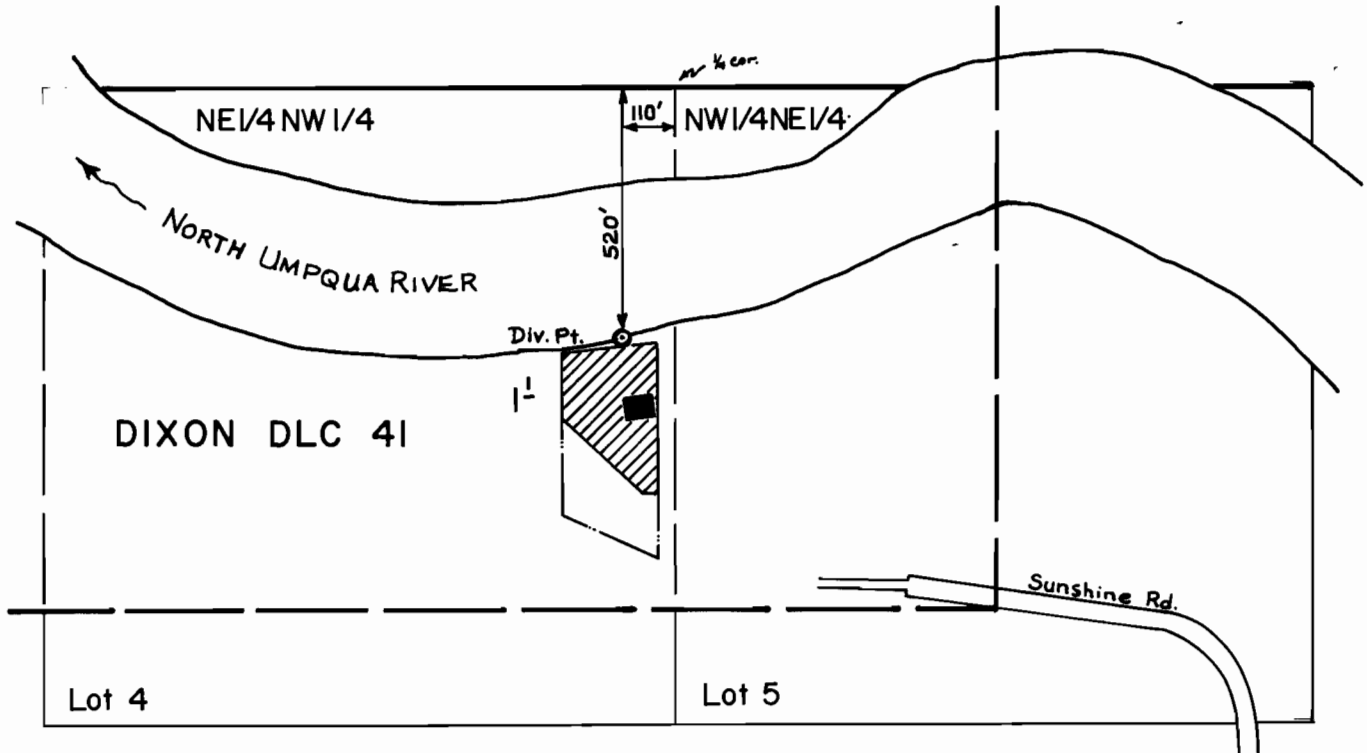

OAK-LAWN ACRES  
Lots 8 & 9

SCALE: 1" = 400'

**FINAL PROOF SURVEY**  
UNDER

Application No. 59276 Permit No. 44548  
IN NAME OF

LOSSIE L. BREEDEN

Surveyed March 17, 1980., by S. Donaldson...