


P-40754

556¹⁹⁷⁵

T.13S. R.30&31E.W.M.

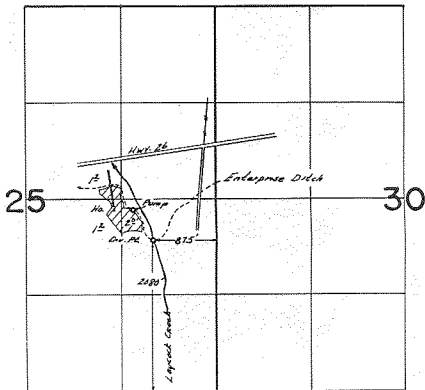

FINAL PROOF SURVEY
UNDER

TRANSFER NO. 3424

Application No. 5.43.7.9. Permit No. 40754...

IN NAME OF

..... L.C. SPAULDING

Surveyed Sept. 18, 1979, by S.C. BROWN