


T.24S.,R.30E.,W.M.

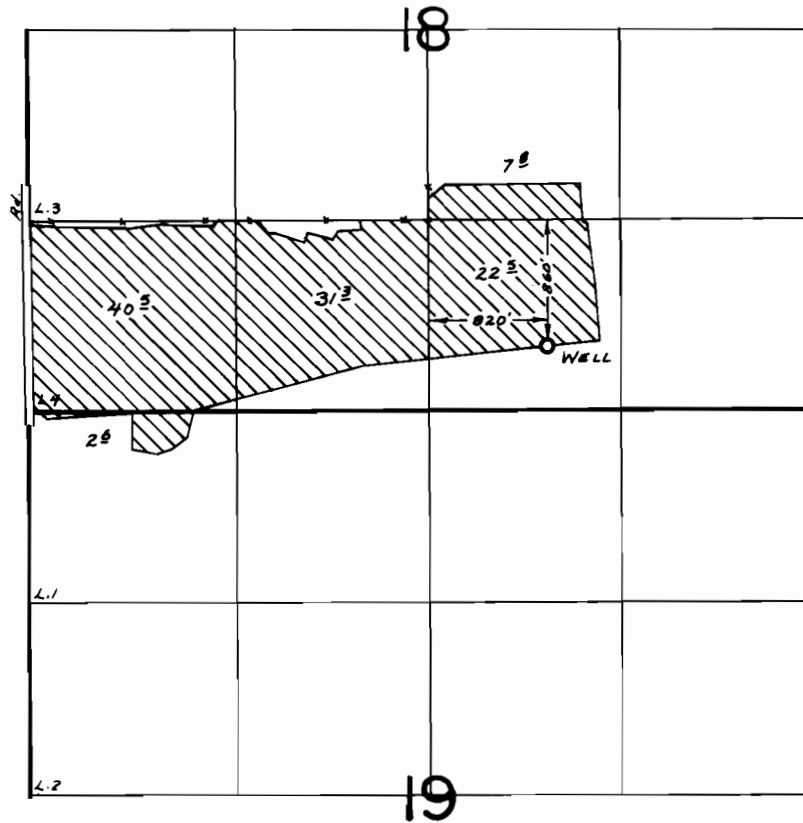

FINAL PROOF SURVEY
UNDER

Application No. G-6953 Permit No. G-6468....
IN NAME OF

.....JOHN W. WILSON.....

Surveyed OCT. 5, 1981, by L. TOLL.....