


P# 48023

T. 2N., R. 10E., W.M.

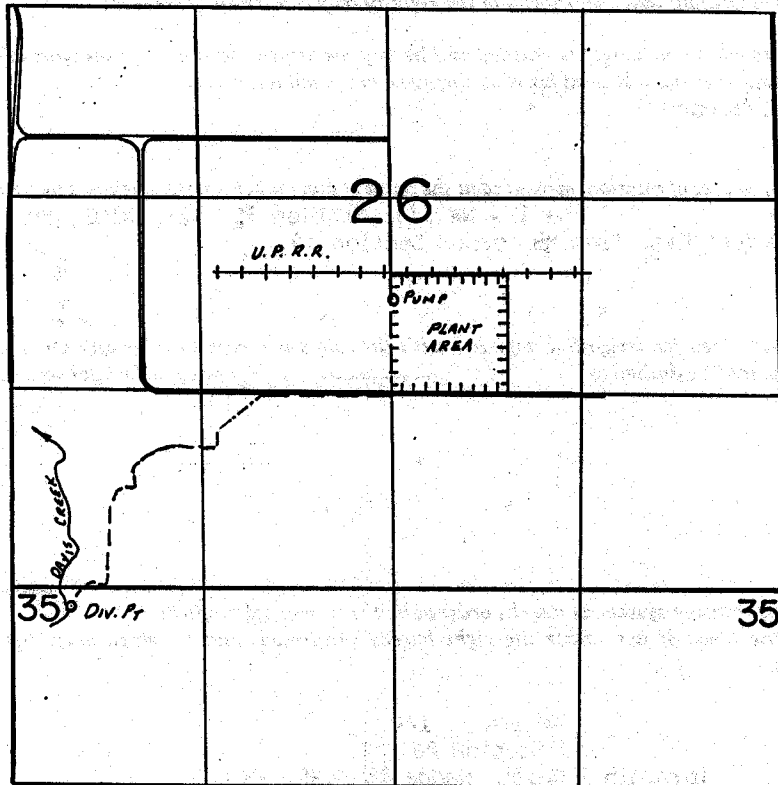

DIV. PT. LOC.: 120 S. & 300 E. FROM NW COR. SEC. 35.

SCALE: 1" = 1320'

FINAL PROOF SURVEY
UNDER

Application No. 65823... Permit No. 48023.....
IN NAME OF

DUCKWALL-POOLEY FRUIT COMPANY

Surveyed Aug. 28.. 19.85, by T.M. WARREN.....

27-87 SE 1/4 Bulb