


T. 32 S., R. 3 E., W. M.

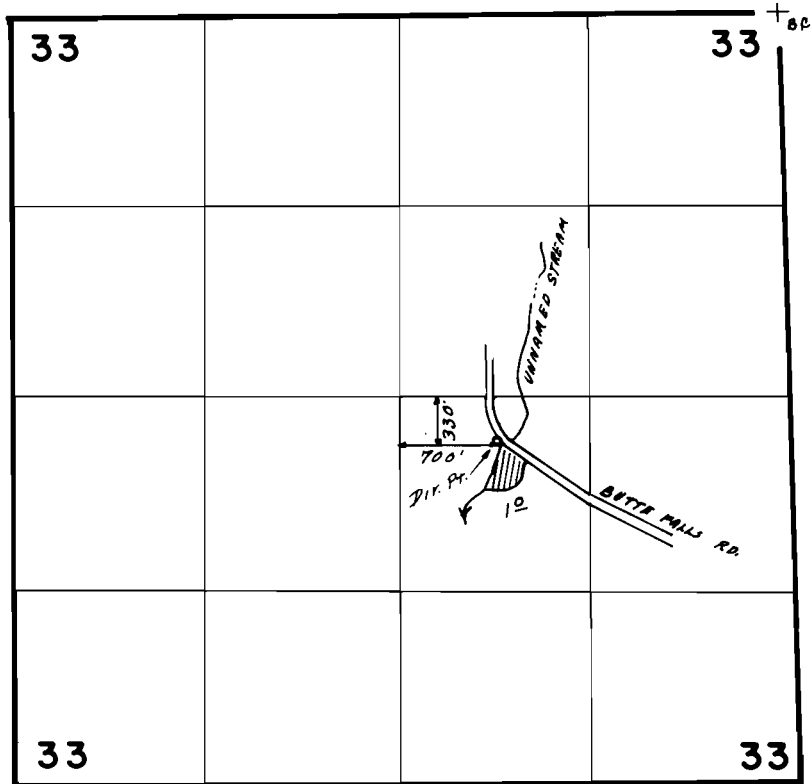

SCALE: 1"=1320'

**FINAL PROOF SURVEY**  
UNDER

Application No. **45761** Permit No. **34158**  
IN NAME OF

**JACK L. HOLLENBEAK**

Surveyed **OCT. 29. 19.85**, by **B. S. JAMES**...