


T. 35 S., R. 2 W., W.M.

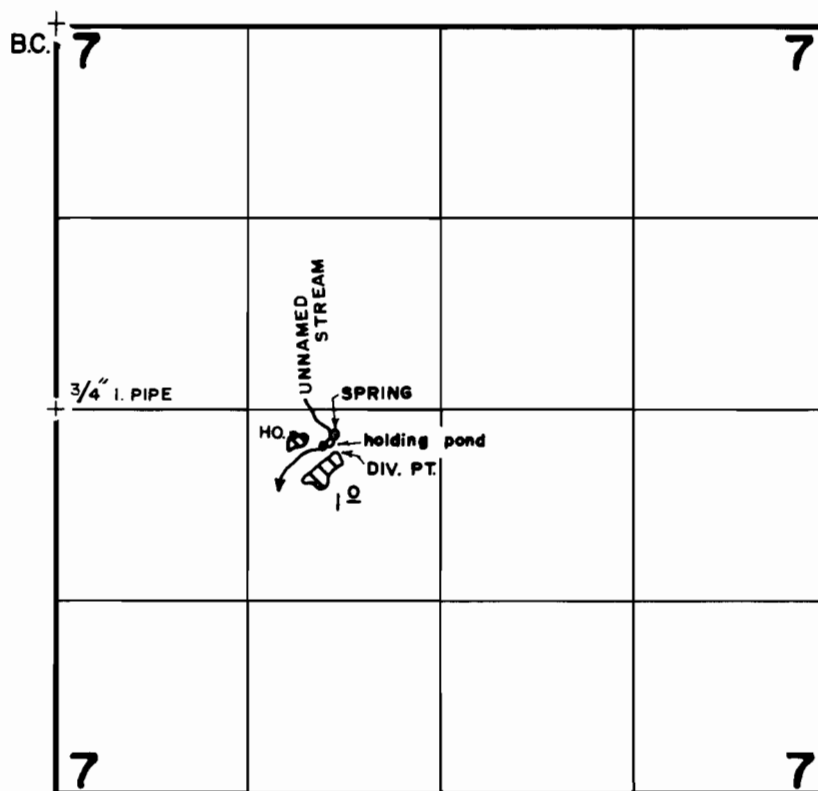

SPRING: 170'S & 1900'E from the W 1/4 COR.

DIV. PT.: 250'S & 1630'E from the W 1/4 COR.

FINAL PROOF SURVEY UNDER

Application No. 53717.. Permit No. 40341....
IN NAME OF

.....STEVEN PLOTNICK.....

Surveyed JULY...23,1982, by B.S. JAMES.....