


T. 35 S., R. 2 W., W.M.
SEC. 1

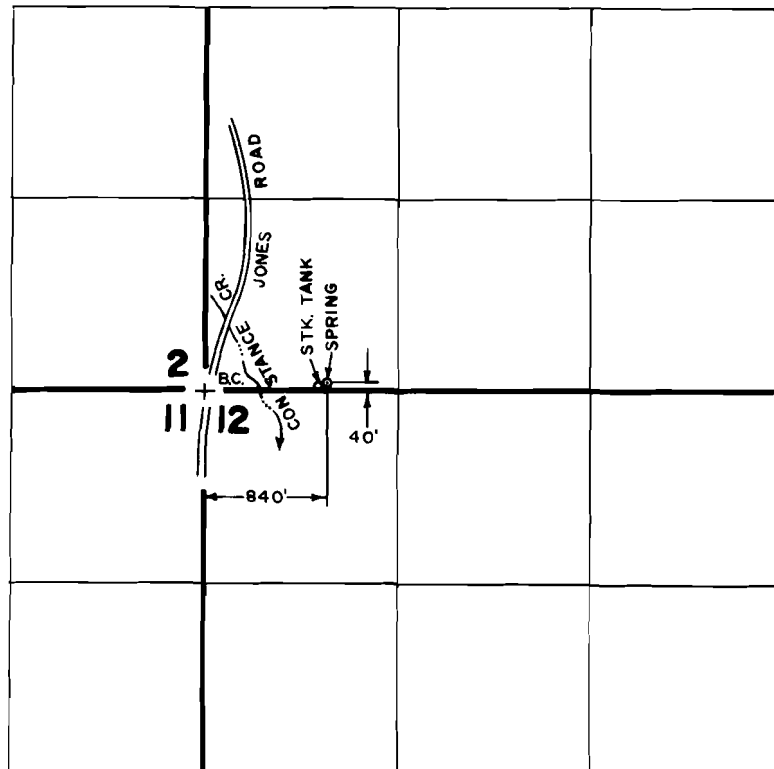

FINAL PROOF SURVEY
UNDER

Application No. **54394** Permit No. **40763**
IN NAME OF

SAUL FOX

Surveyed **JULY 14, 1982**, by **B. SUZIE JAMES**

SCALE: 4" = 1 MILE