


T.39S. R.3W. W.M.

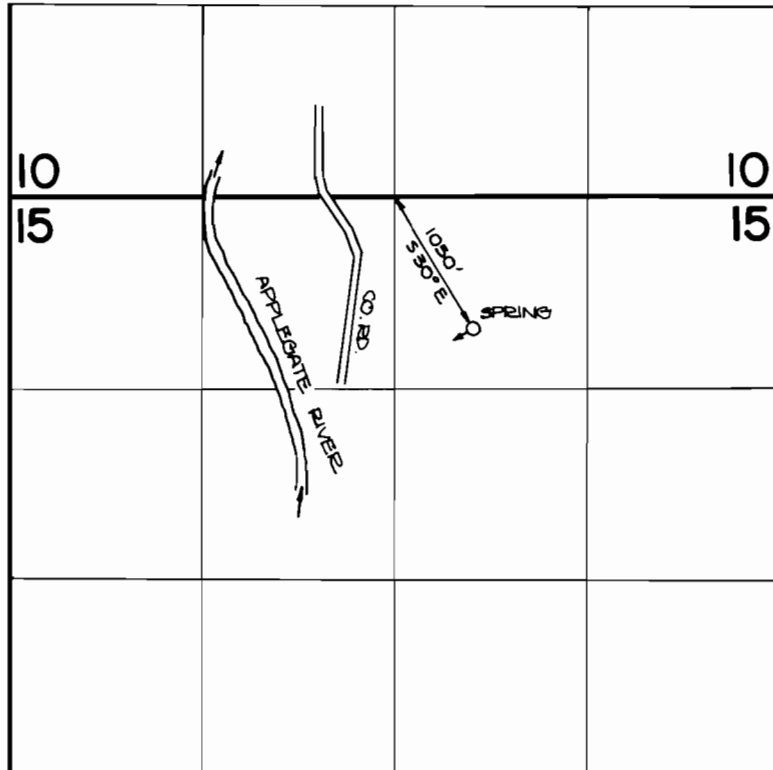

FINAL PROOF SURVEY
UNDER

Application No. **57804** Permit No. **44012**...
IN NAME OF

BUREAU OF LAND MANAGEMENT

Surveyed **APR. 30 1982** by **B. SUND**...