


**T.37 & 38 S., R.5W., W.M.**

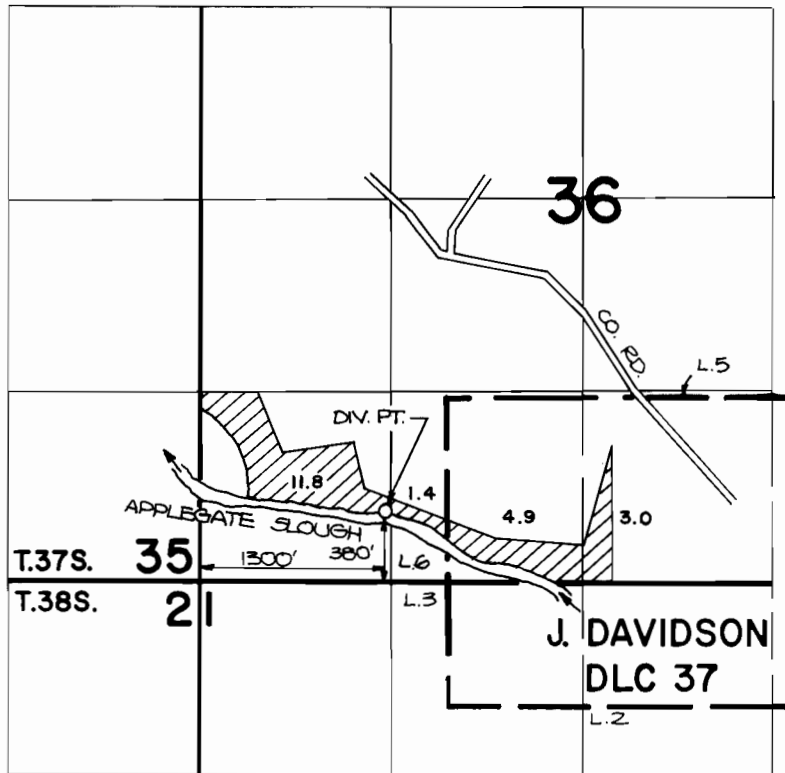

**FINAL PROOF SURVEY**  
UNDER

Application No. ~~57447~~ 62209 Permit No. ~~43268~~ 46080  
IN NAME OF

**JERRY NOBLE**

Surveyed **APR. 29, 1982**, by **B. SUND**