


T.37 & 38 S., R.5W., W.M.

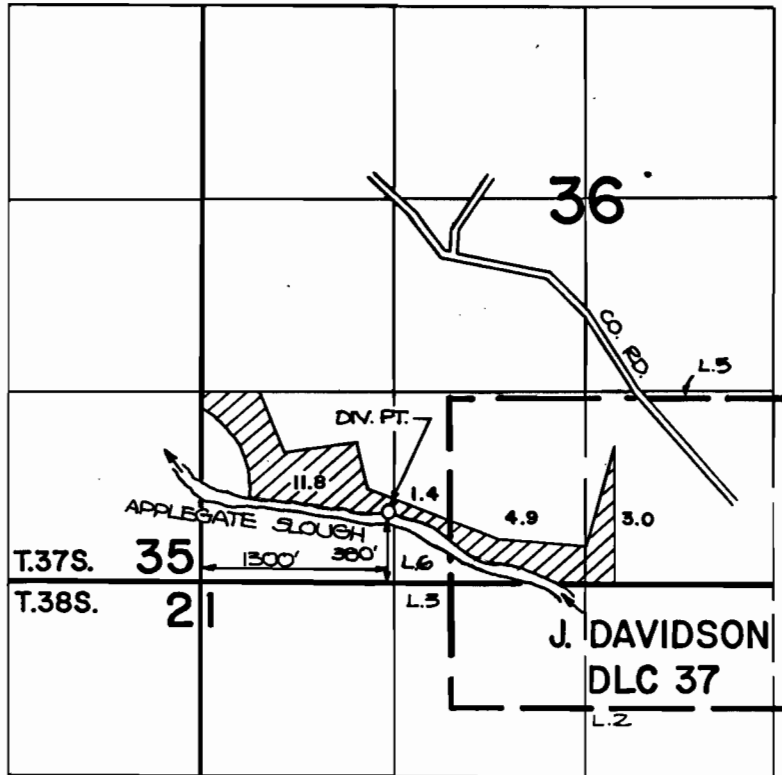

FINAL PROOF SURVEY UNDER

Application No. **62209** **57447** Permit No. **46080** **43268**....
IN NAME OF

JERRY NOBLE

Surveyed **APR. 29, 1982**, by **...B...SUND**.....