


T.35S., R.6W., W.M.

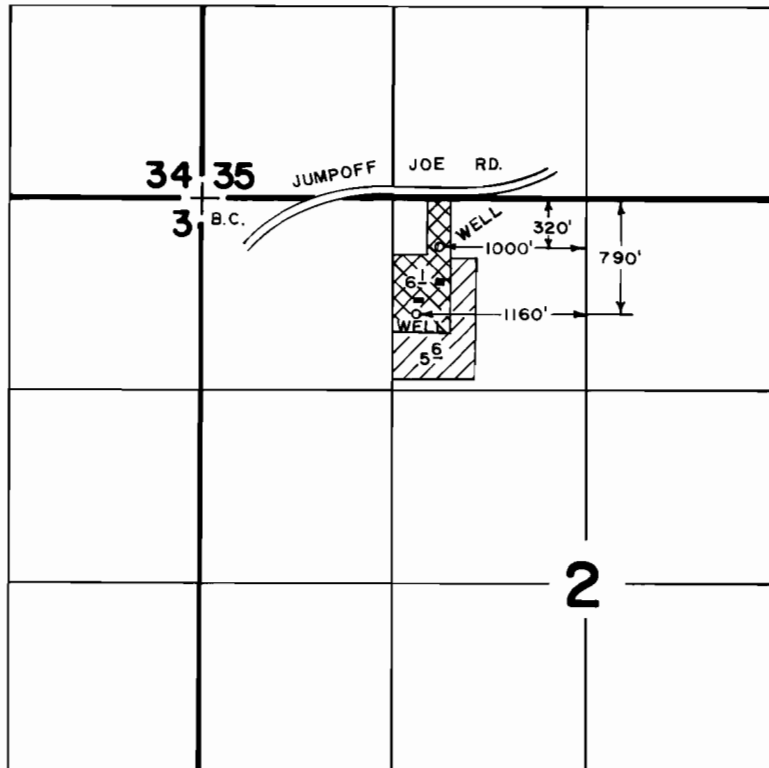

FINAL PROOF SURVEY
UNDER

Application No. **G-8435** Permit No. **G-7889**
G-5945 **G-5644**
IN NAME OF

JOHN L. IVES

Surveyed **SEPT. 15** 19**82**, by **B. SUZIE JAMES**

SCALE: 4" = 1 MILE

☒ PRIMARY
☒ SUPPLEMENTAL