


T. 27S., R. 17E., W.M.

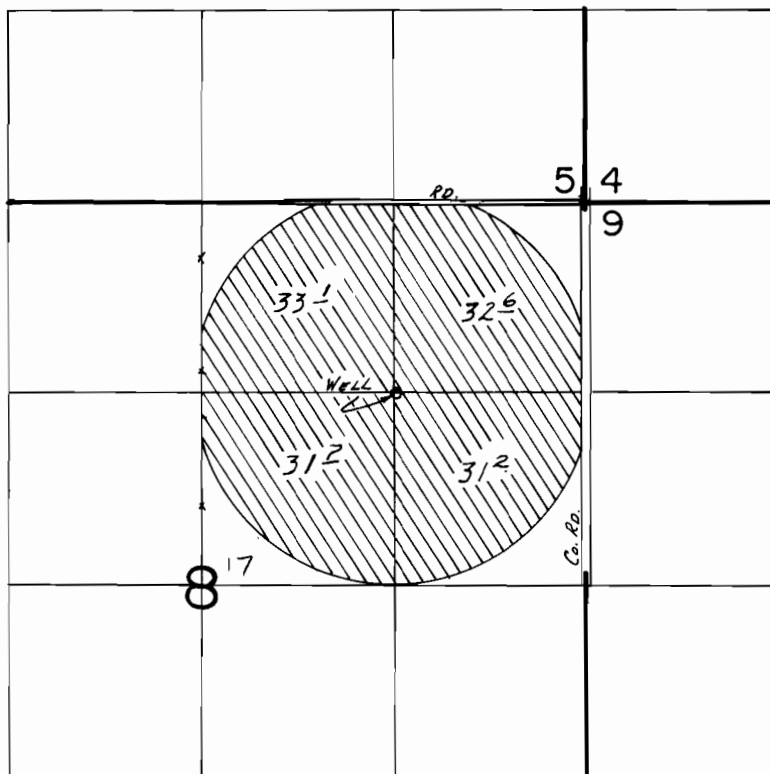

WELL LOC.: 1320' S. & 1300' W. FROM NE COR. SEC. 8.

SCALE: 1" = 1320'

FINAL PROOF SURVEY UNDER

Application No. G-8745. Permit No. G-8247.....
IN NAME OF

.....GOLDEN RULE FARMS, INC.....

Surveyed Oct. 10..... 1985, by B.W. BISHOP.....