


G-9016
55703



T. 26 S., R. 18 E., W.M.

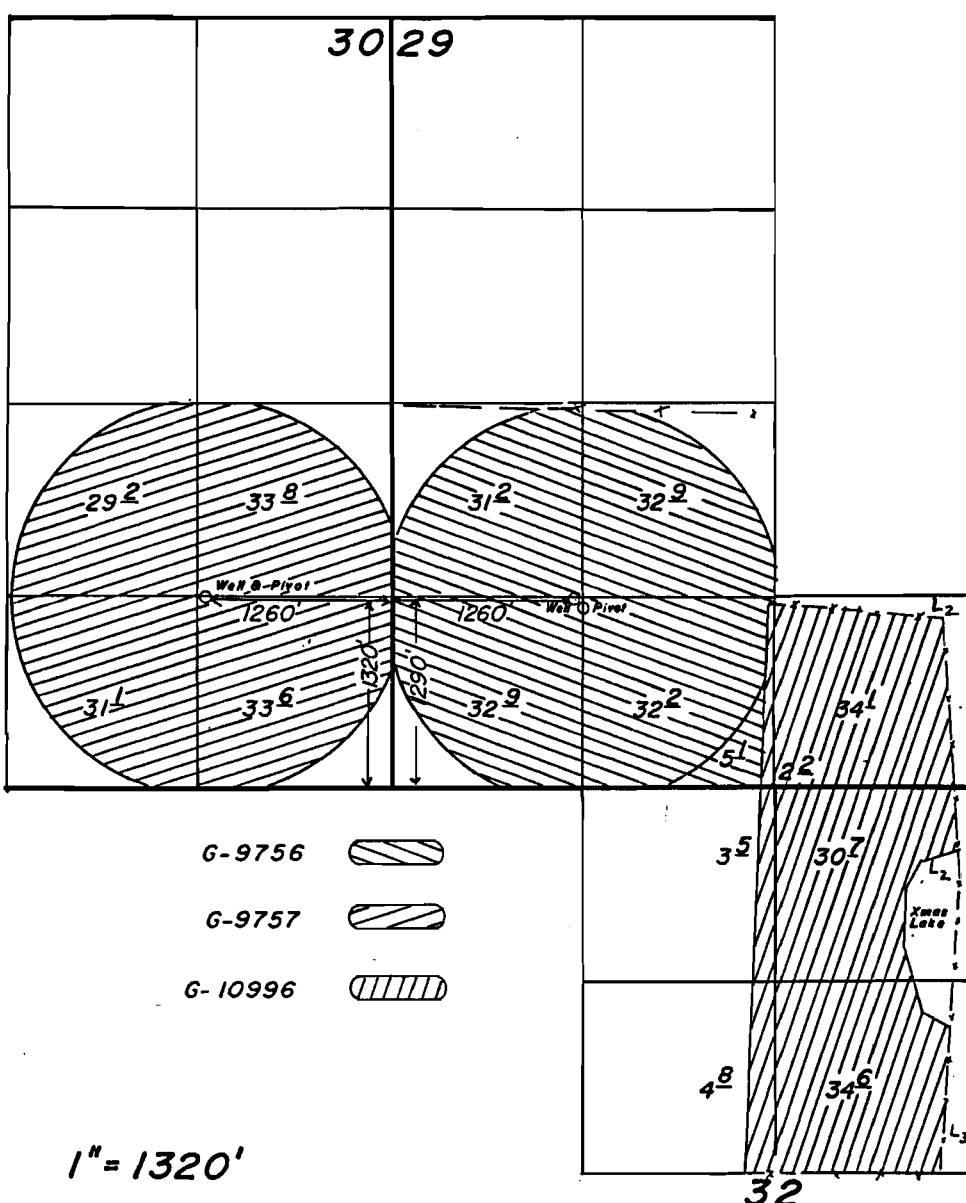

FINAL PROOF SURVEY

UNDER

G-9756 ✓
G-9757 ✓

G-9015 ✓
G-9016 ✓

Application No. G-10996 Permit No. G-10172

IN NAME OF

LARRY GRASSMAN

Surveyed Oct. 25, 1984, by Leslie Olson

PTS-11-1984-D

T.M.W.