
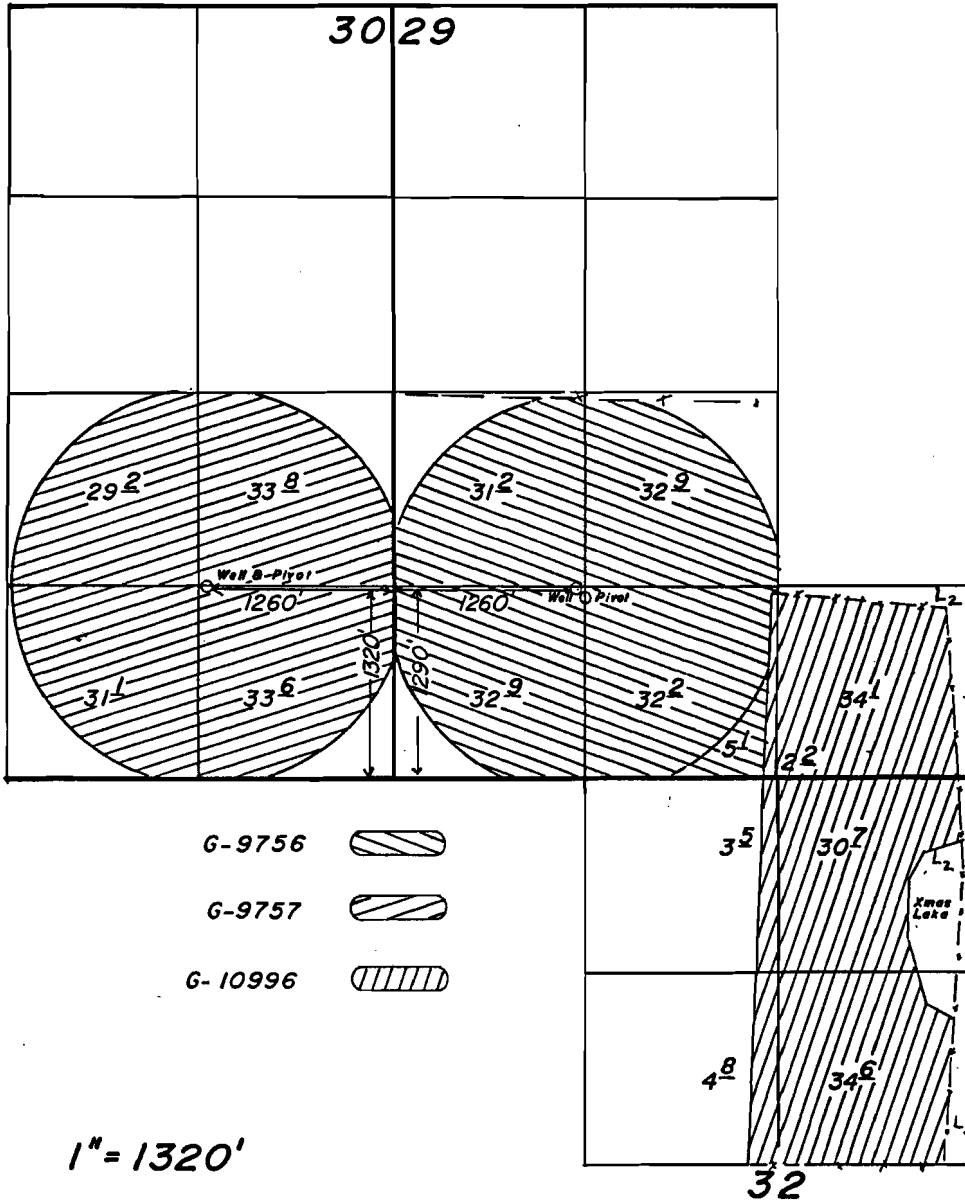


T. 26 S., R. 18 E., W.M.

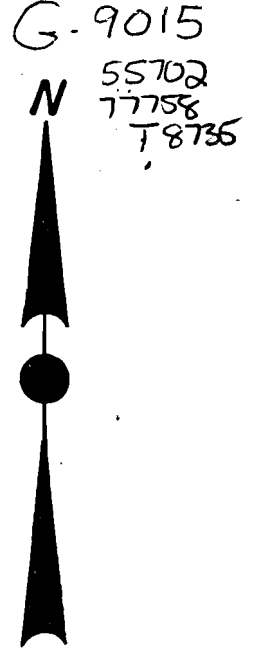

FINAL PROOF SURVEY

UNDER

G-9756 ✓

G-9015 ✓

G-9757 ✓

G-9016 ✓

Application No. ~~G-10996~~ Permit No. ~~G-10172~~....

IN NAME OF

.....LARRY GRASSMAN.....

Surveyed Oct. 25, 1984, by Leslie Olson.....

PTS-11-1984-D

T.M.W.