


T.15S. R.4&5W. W.M.

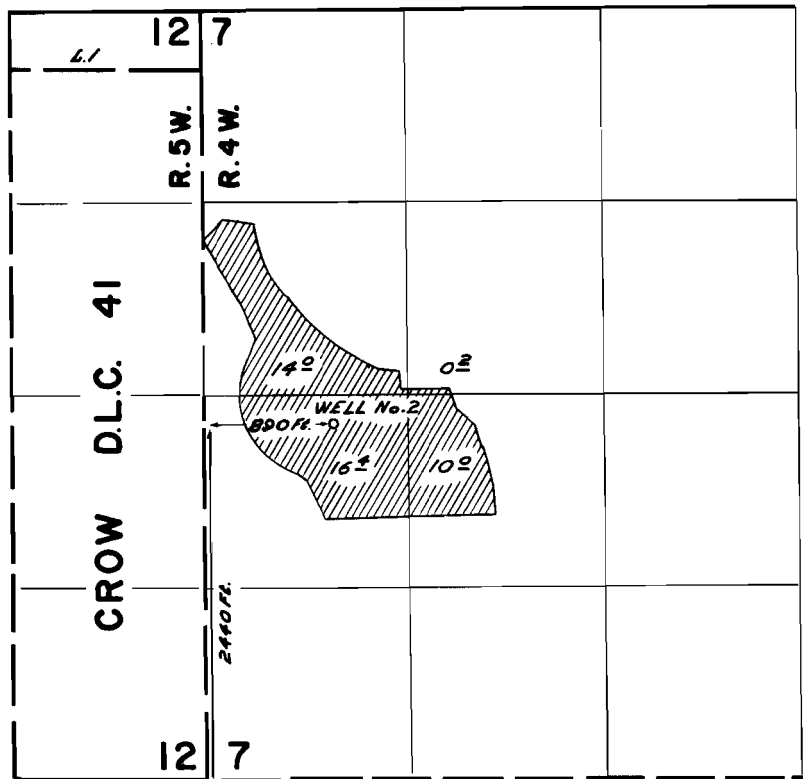

FINAL PROOF SURVEY
UNDER

Application No. G-2591 Permit No. G-2417
IN NAME OF

EARL C. & RAYMOND JAGER

Surveyed APR. 29 1965, by L. COLEBANK