


T. 15S. R. 5W. W.M.

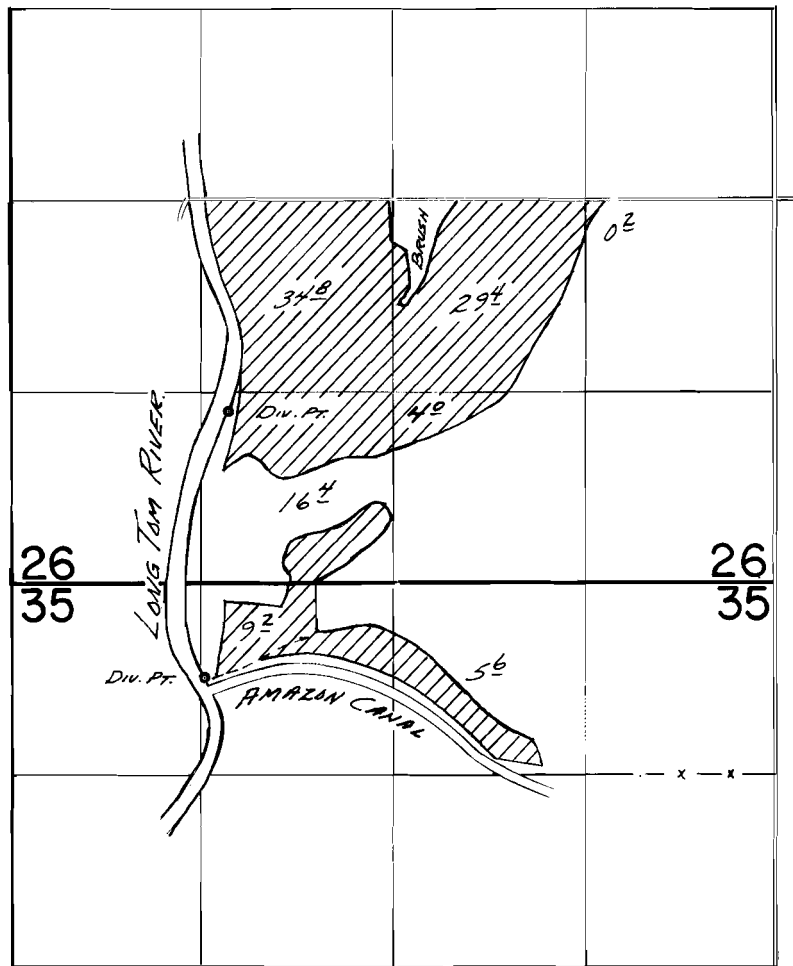

Div. Pts. Loc. North - 1170'N + 1300'W } Both from 5 1/4
South - 650'S. & 1140'W } Cor. Sec. 26

FINAL PROOF SURVEY UNDER

Application No. 56005. Permit No. 41941.....
IN NAME OF

.....Farmers Home Administration.....

Surveyed Oct..11..... 1979., by C.R.RODRIGUEZ.