


Map of Ada Benfield Water Right

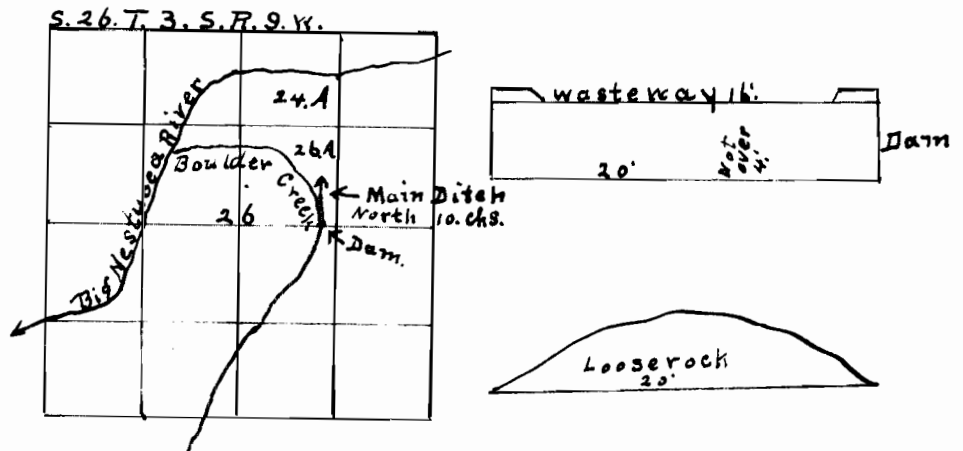

CERTIFICATE OF SURVEYOR

I A. M. AUSTIN, of TILLAMOOK COUNTY, OREGON, do hereby certify that this map was made from notes taken during an actual survey made by me on September 23rd 1922. and that it correctly represents the works described in the accompanying application, together with the location of streams and other ditches in the immediate vicinity, and has written thereon the area in each smallest legal subdivision which it is proposed to irrigate.

Andrew M. Austin

Surveyor-



A-8569
P-5657