


T.18S.R.10W.W.M.

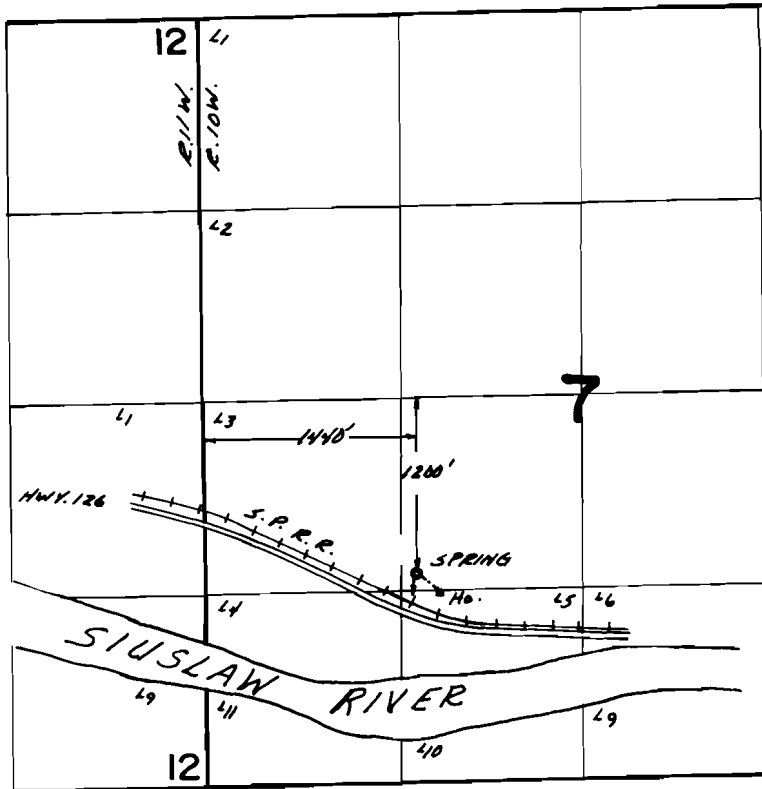

FINAL PROOF SURVEY UNDER

Application No. **58446**. Permit No. **44253**.....
IN NAME OF

.....DAVID L. DIER.....

Surveyed Aug...**9**... 1979., by **S.C. BROWN**.....