


T.13S., R.3&4W., W.M.

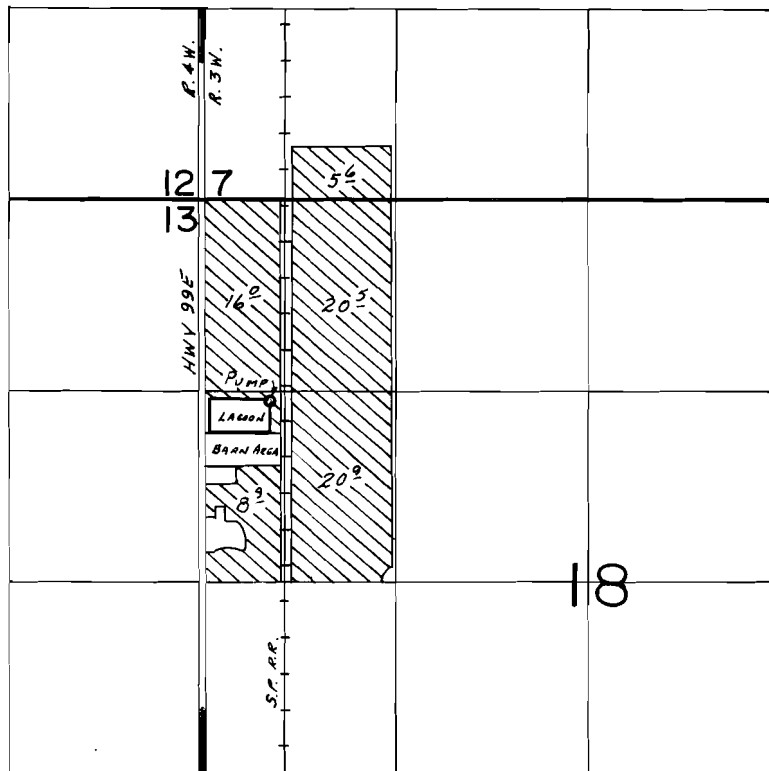

DIV. PT. LOC.: 1390'S. & 470'E. FROM NW COR. SEC. 18.

SCALE: 1"=1320'

FINAL PROOF SURVEY

UNDER

R-58743 R-7932
Application No. 58744. Permit No. 44402....
IN NAME OF

.....PUGH CENTURY DAIRY FARM.....

Surveyed Oct. 2..... 19.85, by T.M. WARREN.....