


T. 9 S., R. 3 E., W.M.

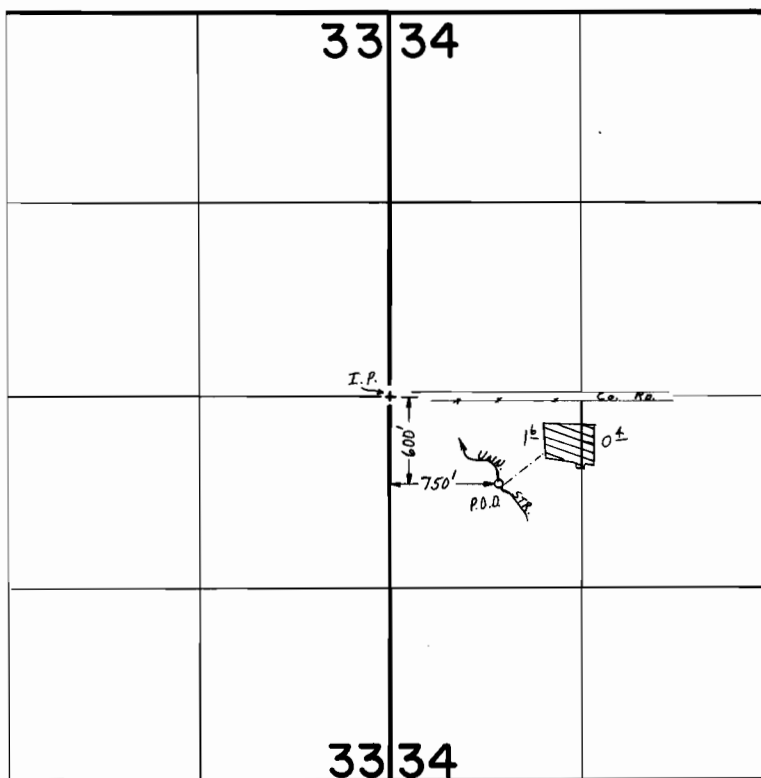

Scale: 1" = 1320'

FINAL PROOF SURVEY

UNDER

Application No. 62387... Permit No. 46228.....
IN NAME OF

.....SHARON D. BLAYLOCK.....

Surveyed May 8, 1986, by T. Warren.....