


T.7 S. R.2 W. W.M.

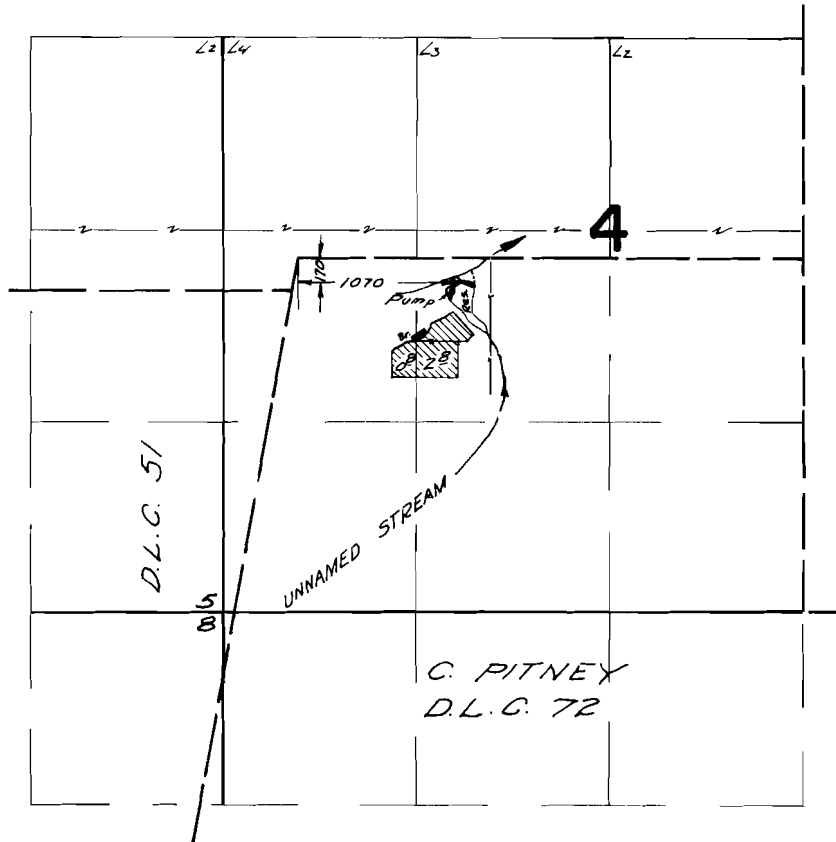

FINAL PROOF SURVEY
UNDER

R-40212 R-4491
Application No. 40213... Permit No. 29993.
IN NAME OF

ALBERT I. NEEDHAM

Surveyed Nov. 22, 1967, by V. Garner