


T9S R3W WM

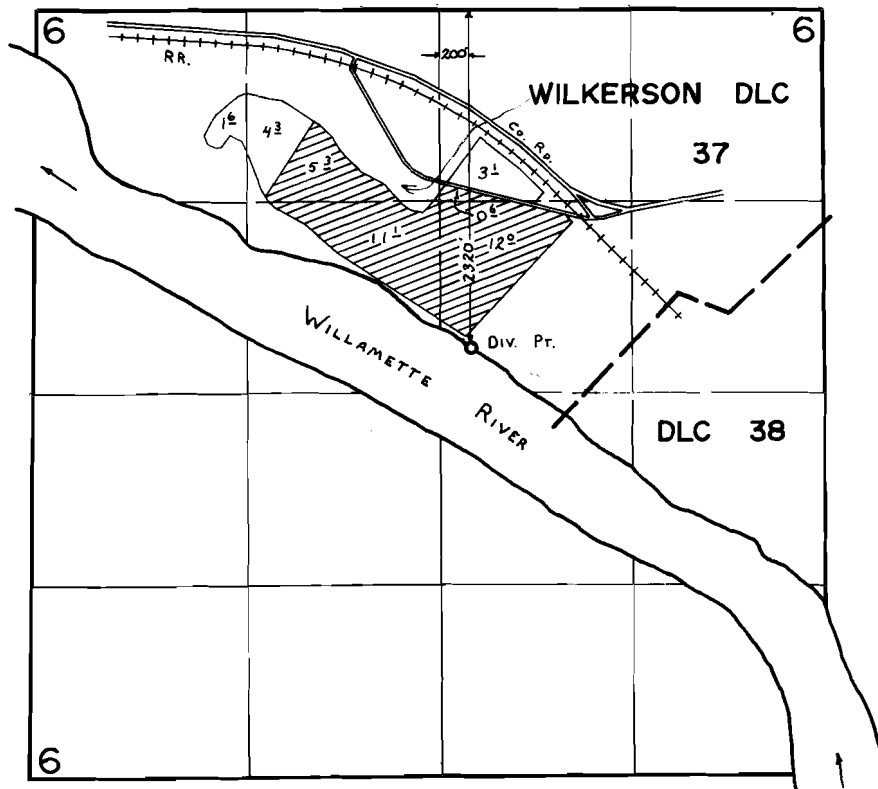

FINAL PROOF SURVEY UNDER

Application No. 55244. Permit No. 41622.....
IN NAME OF

.....LILLIAN HAMPTON.....

Surveyed APR. 23. 19.80., byC. L. HUGHES.....