


# T.6S.R.3W.W.M.

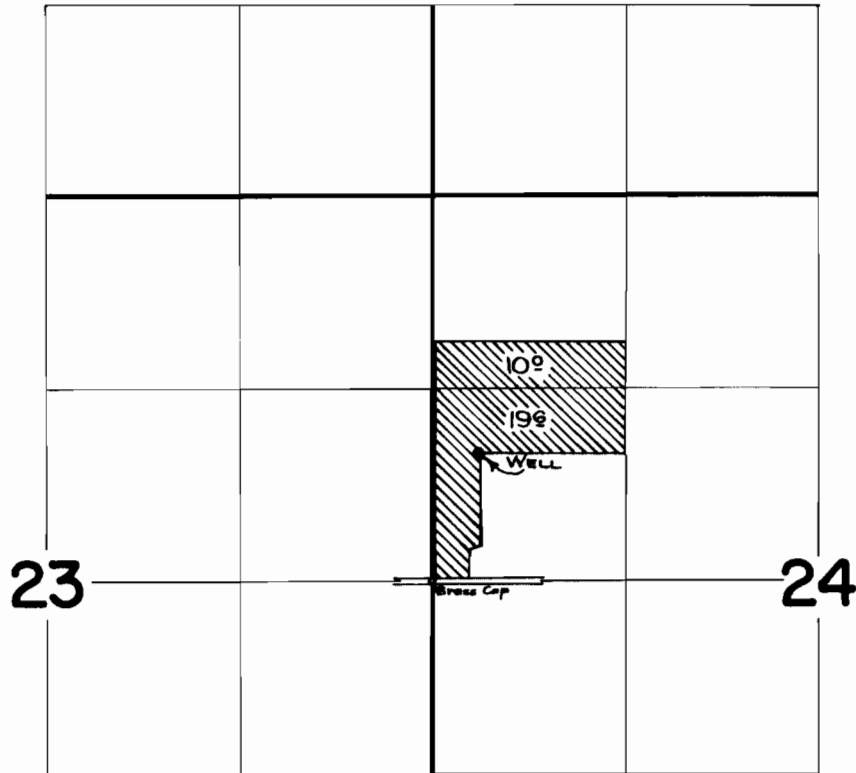

*Well is located 270 ft. North and 310 ft. East from West 1/4 Cor. Sec. 24*

## FINAL PROOF SURVEY UNDER

Application No. G-872 Permit No. G-771  
IN NAME OF

B. J. OPPEK

Surveyed April 24, 1963, by T. Lauer  
June 18, 1905 by R. Jackson