


T.5S. R.2W. W.M.

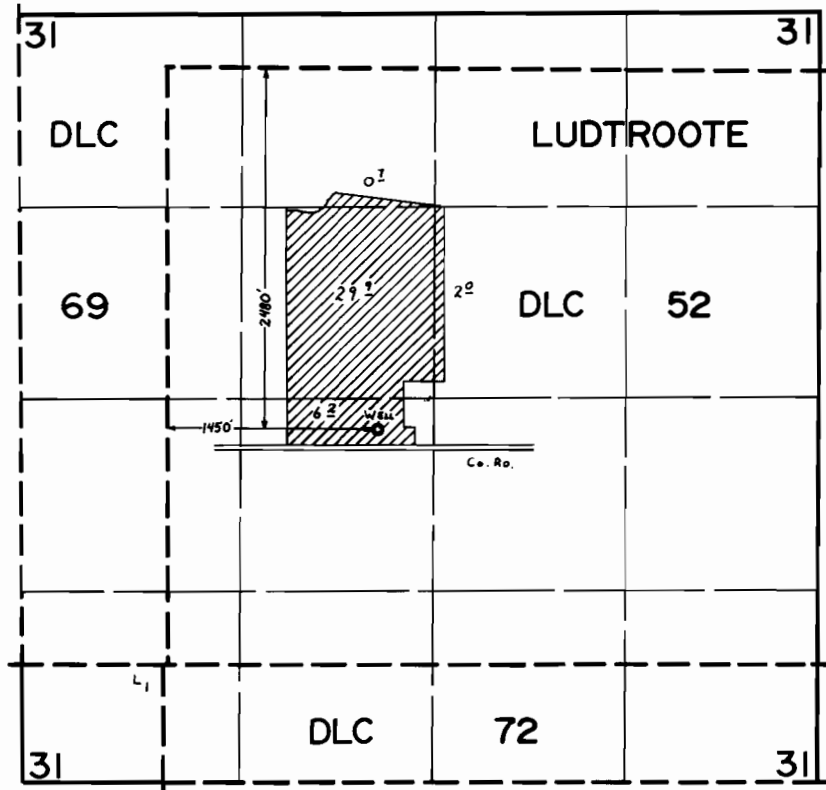

FINAL PROOF SURVEY UNDER

Application No. G-9338. Permit No. G-8716.....
IN NAME OF

.....RICHARD L. GRASSMAN.....

Surveyed June 30, 1980, by G. L. Hughes.....