


T.6S., R.1W., W.M.

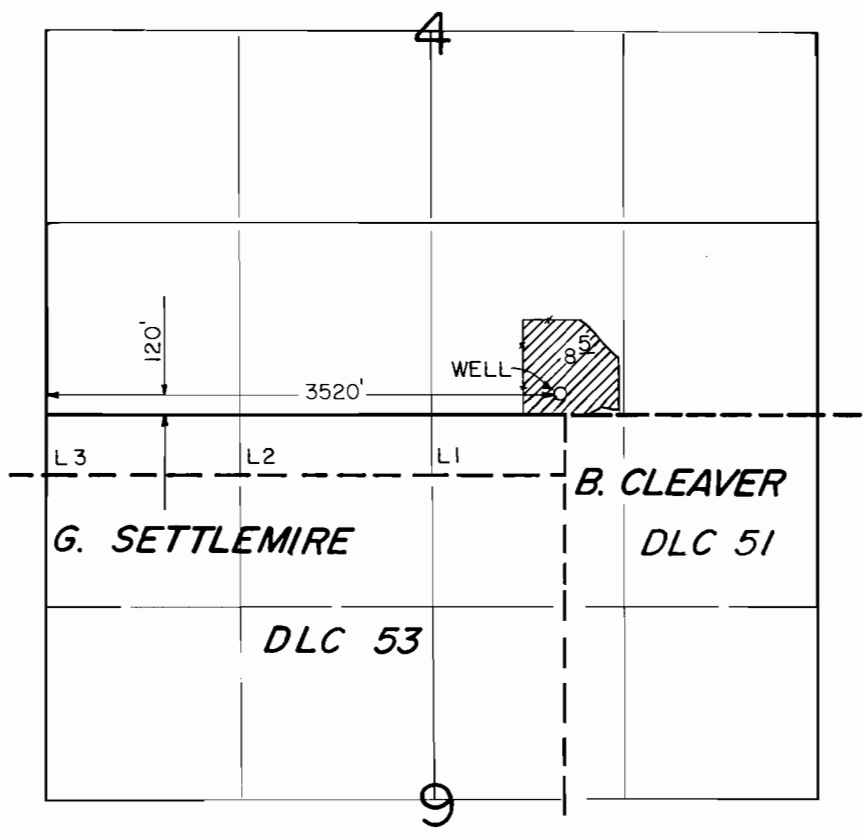

SCALE 1" = 1320'

FINAL PROOF SURVEY
UNDER

Application No. G-10557 Permit No. G-9445
IN NAME OF

GUADALUPE GUERRERO

Surveyed APRIL 8, 1986, by T. M. WARREN