


T.2S.R.1W.W.M.

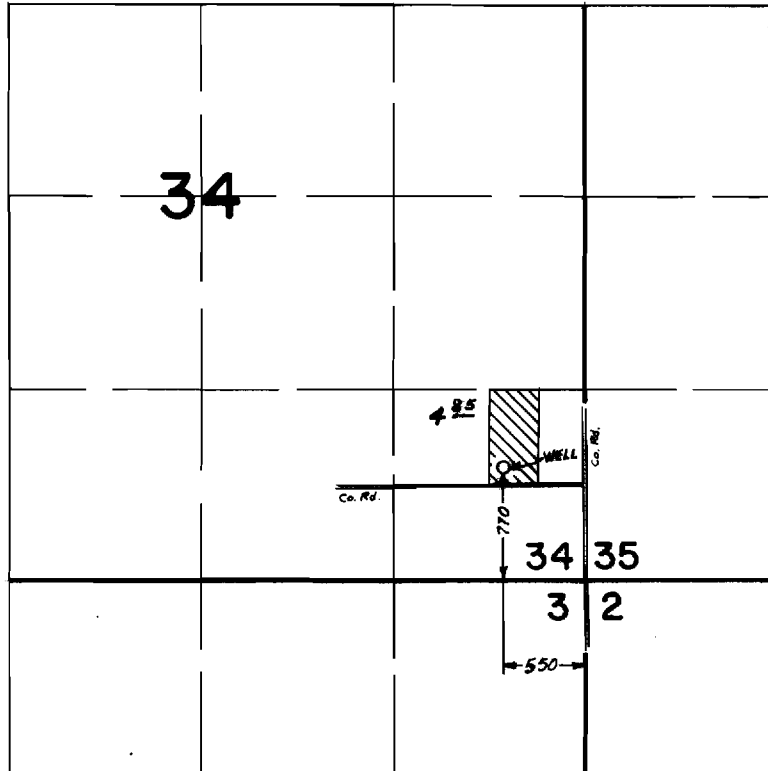

FINAL PROOF SURVEY
UNDER

Application No. G-3701 Permit No. G-3502
IN NAME OF

LEE H. & MARION B. THOMPSON

Surveyed OCT 6 1972, by L. GOULD