


# T. 26 S., R. 3 W., W.M.

## SECTION II

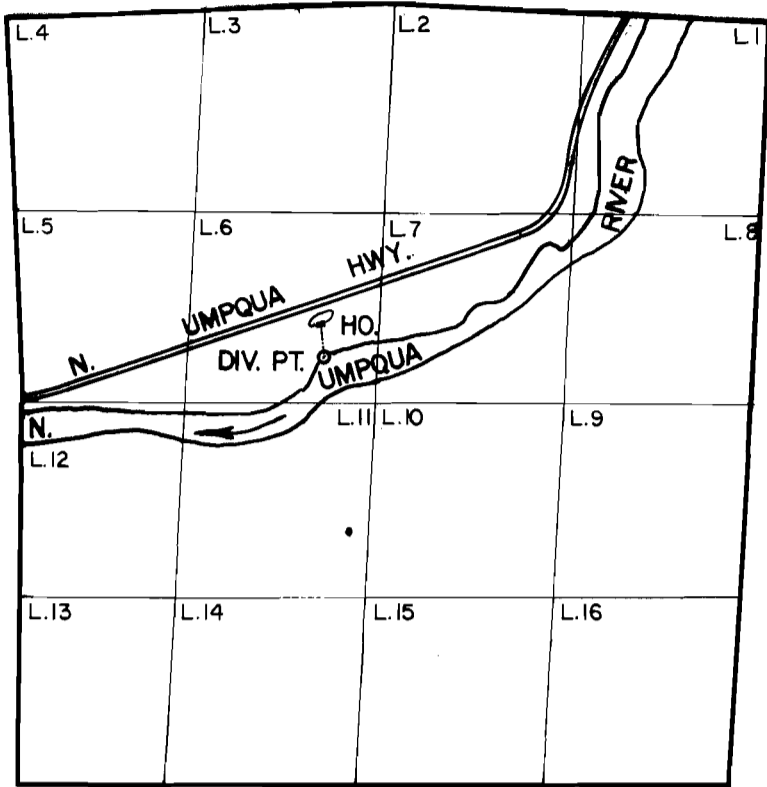

DIV. PT. IS LOCATED 320' N. & 2070' E. FROM W. 1/4 CORNER SEC. II

SCALE: 4" = 1 MILE

### FINAL PROOF SURVEY UNDER

Application No. 63058... Permit No. 46688...  
IN NAME OF

.....MYRON E. VLCEK.....

Surveyed SEPT. 18, 1986, by J.M. SCHMORDE...