


T. 26 S., R. 3 W., W.M.

SECTION II

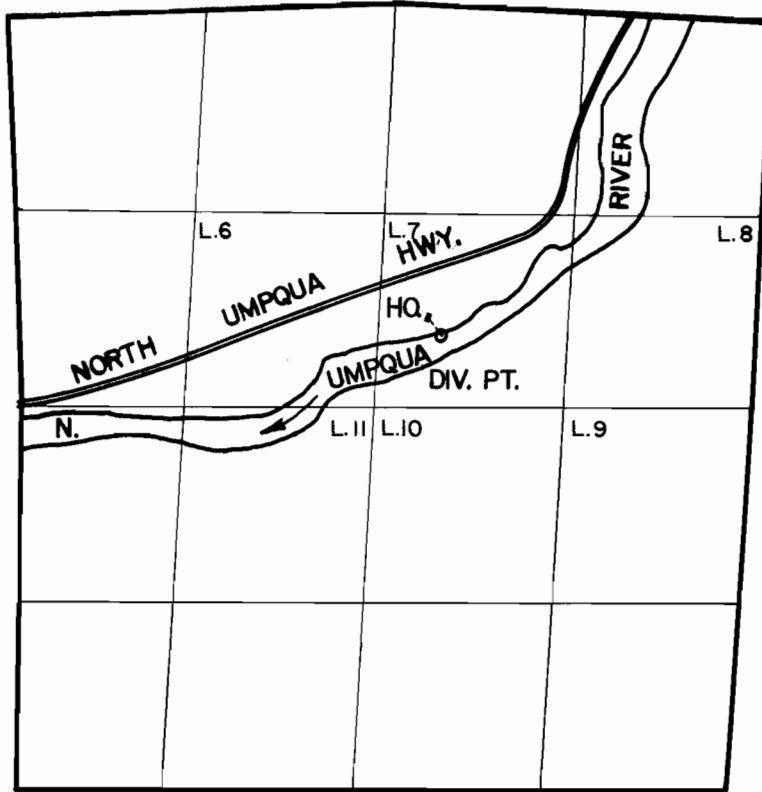

DIV. PT. IS LOCATED 490' N. & 2900' E. FROM W. 1/4 CORNER SEC. II

SCALE: 4" = 1 MILE

FINAL PROOF SURVEY UNDER

Application No. 65305 Permit No. 47687.....
IN NAME OF

JAMES & JEANNE WALLACE.....

Surveyed SEPT. 18, 19.86, by J.M. SCHMORDE..