


T. 26S., R. 6W., W.M.

SEC. 33

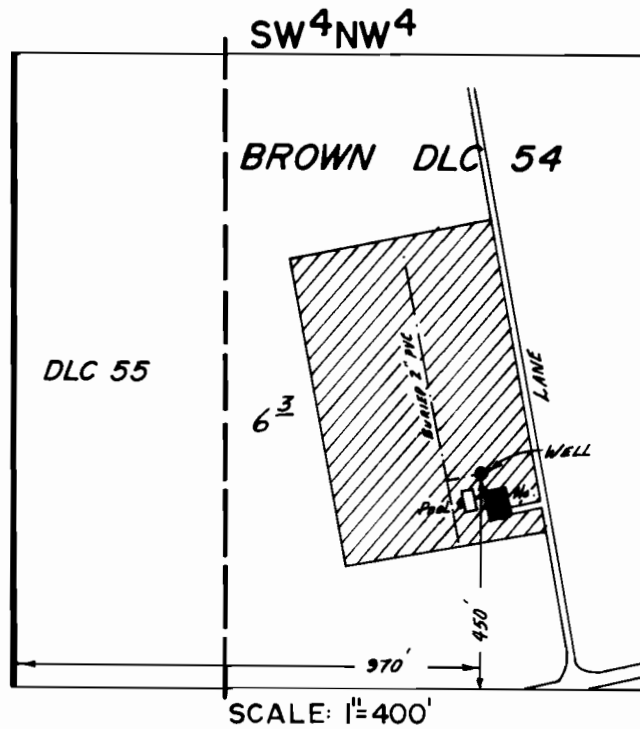

FINAL PROOF SURVEY
UNDER

Application No. G-6275. Permit No. G-5908.....
IN NAME OF

.....*GARLYN HALL & D.V.A.*.....

Surveyed JUNE 19... 1979, by J.S. DONALDSON.