


P. 26 987

6

55743
38694

T 11 S. R. 34 & 35 E. W. M.

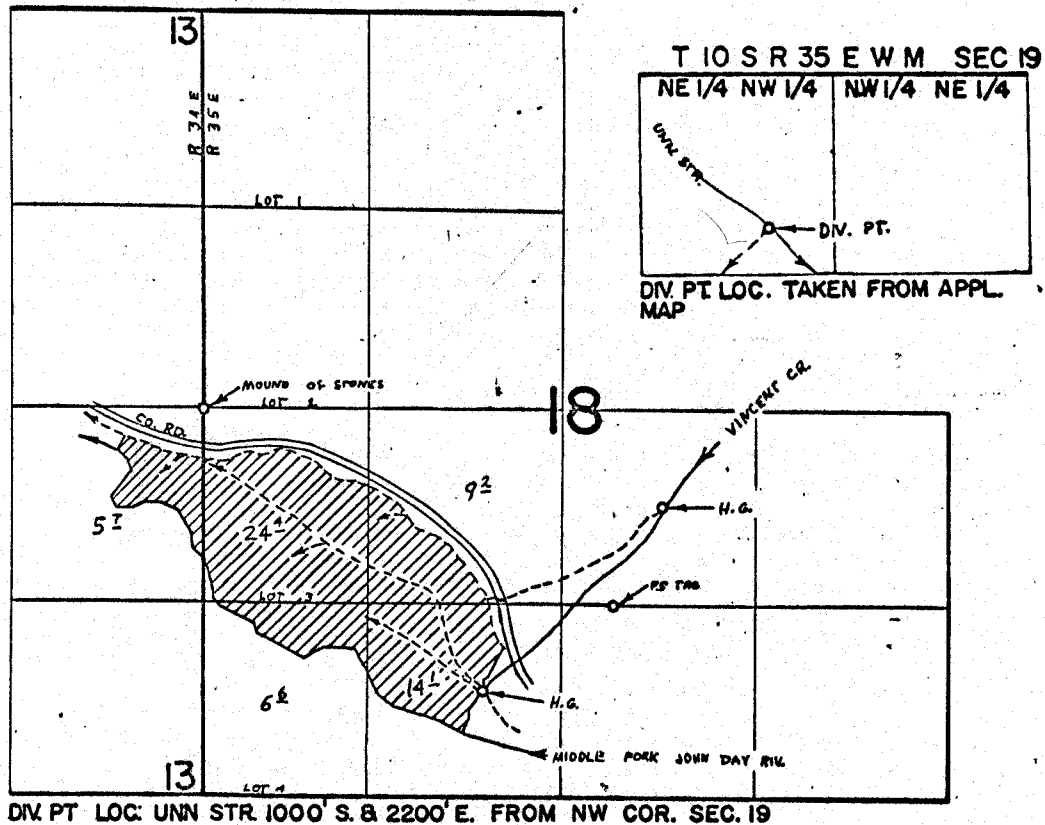

FINAL PROOF SURVEY UNDER

Application No. 34339.... Permit No. 26987.....
IN NAME OF

.....ORRIN FORREST.....

Surveyed AUG. 27., 1971., by R. MUCKEN.....