


# T. 24S., R. 29E., W.M.

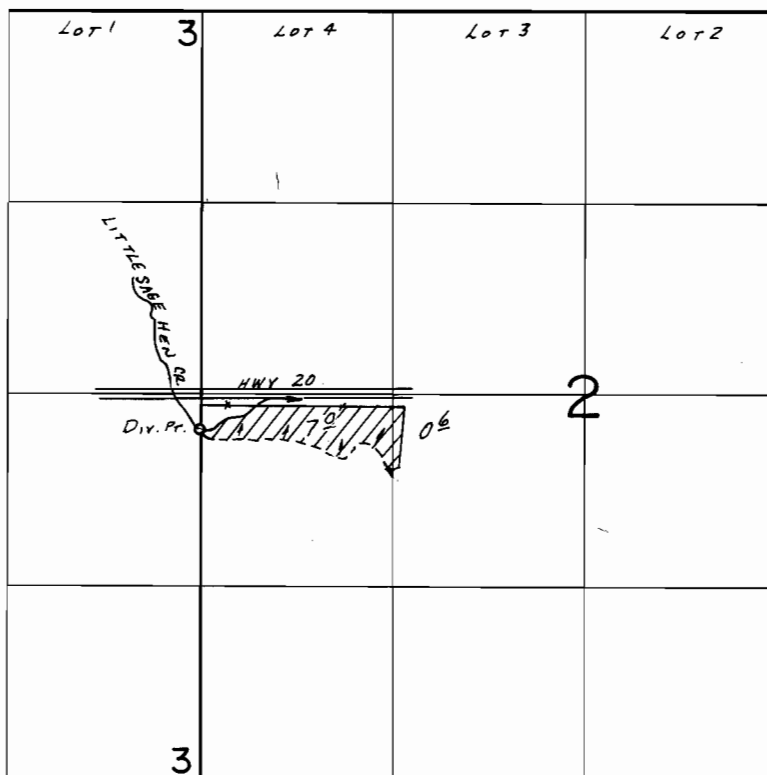

Div. Pt. Loc.: 250' S. & 10' W. FROM E. 1/4 COR. SEC. 3.

SCALE: 1" = 1320'

## FINAL PROOF SURVEY UNDER

Application No. 59916... Permit No. 45056.....  
IN NAME OF

.....JIM AND RAMONA BISHOP.....

Surveyed Mar. 17... 19.86, by DON CLARK.....

11/10/86  
BWB