




T. 3 N., R. 10 E., W.M.

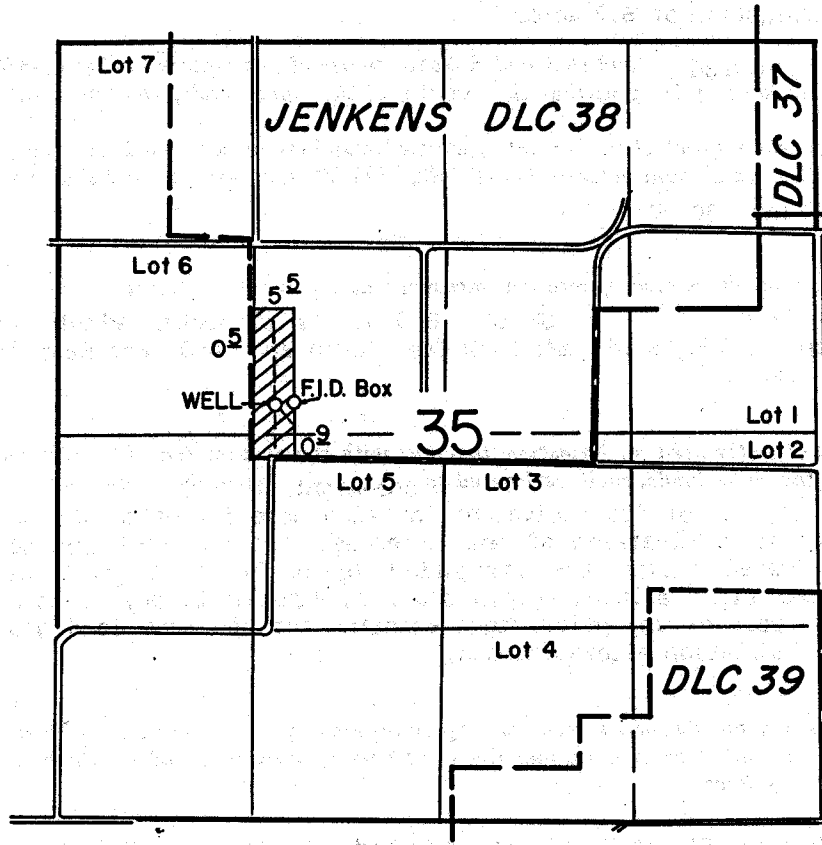

WELL LOC: 2450' S. & 1460' E. FROM N.W. CORNER SECTION 35

SCALE: 1" = 1320'

FINAL PROOF SURVEY
UNDER

Application No. G-8322, Permit No. G-7680
IN NAME OF

.....**CHALLIS E. CAMPBELL**.....

Surveyed Sept. 23, 1981, by L.M. TOLL.....

Redraft 11-14-86
27-87 NE 1/4 *JL*