


T. 38 S., R. 1 W., W.M.

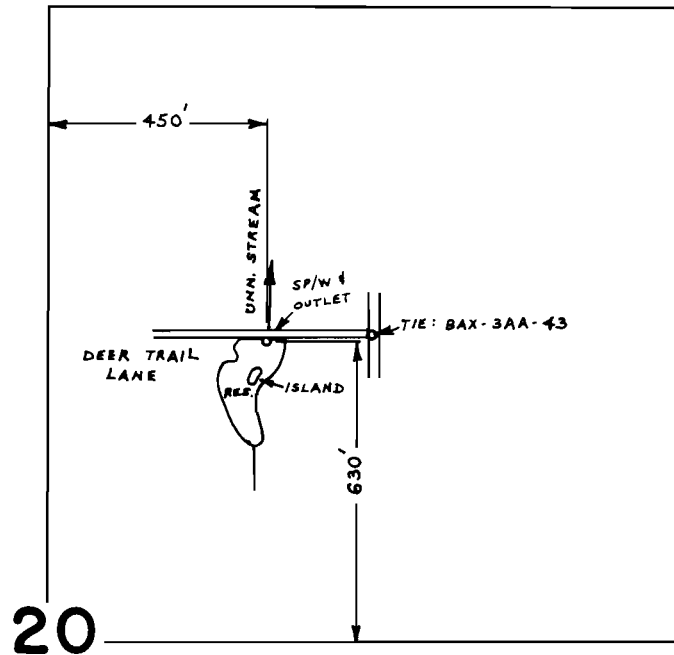

SCALE : 1" = 400 FT.

FINAL PROOF SURVEY UNDER

Application No. R-52037 Permit No. R-6282
IN NAME OF

WILLIAM C. AND LUCINDA FERGUSON

Surveyed MAY 2 1979, by B. SUND

D.H.M.
P.T.S.-1979-14-A