


T.39 S., R.4 W., W.M.

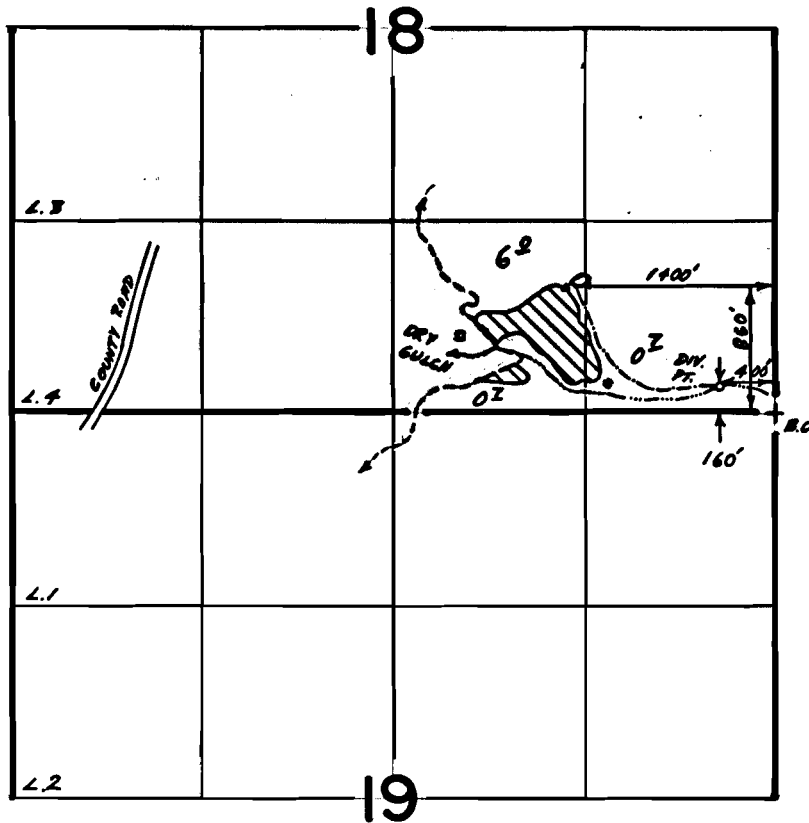

Scale : 1" = 1320'

FINAL PROOF SURVEY
UNDER

R-56986 R-7028
Application No. 56987 Permit No. 42895
IN NAME OF

...B.N. & or LORETTA LANDRUM

Surveyed MAY 26 1982, by B.R.SUND